


# T.17 S.R.3 W.W.M.

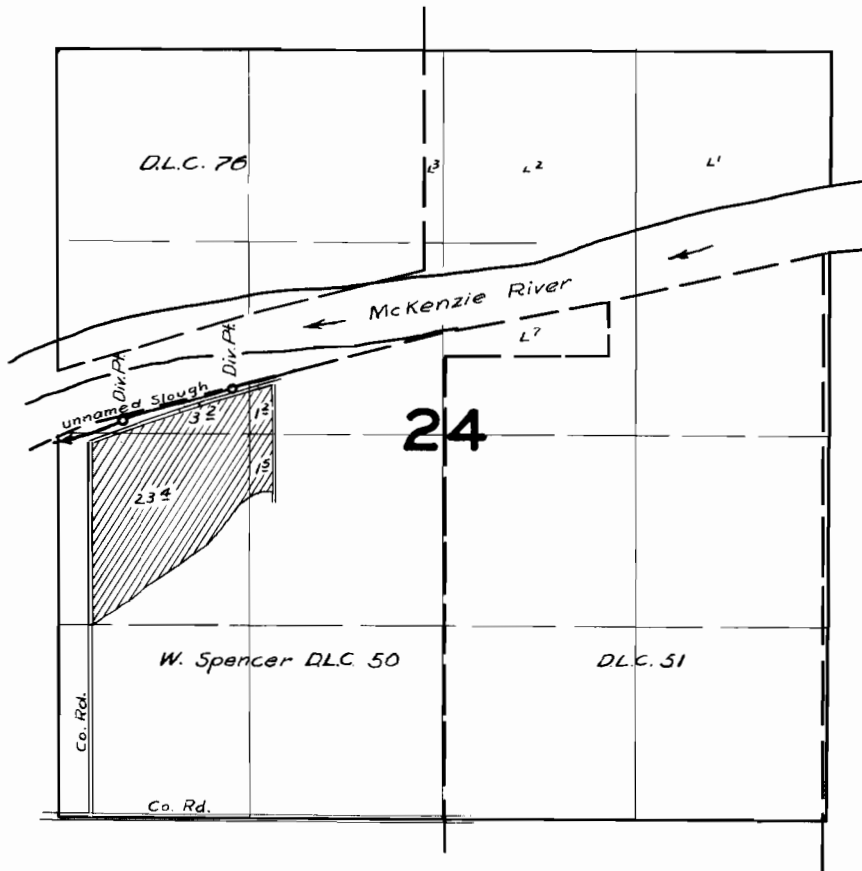

## FINAL PROOF SURVEY

UNDER

Application No. 29838 Permit No. 23577  
IN NAME OF

*Homer W. Chase*

Surveyed April 30 1957, by *Tom Bisk*