


T. 32S. R. 5W. W.M.

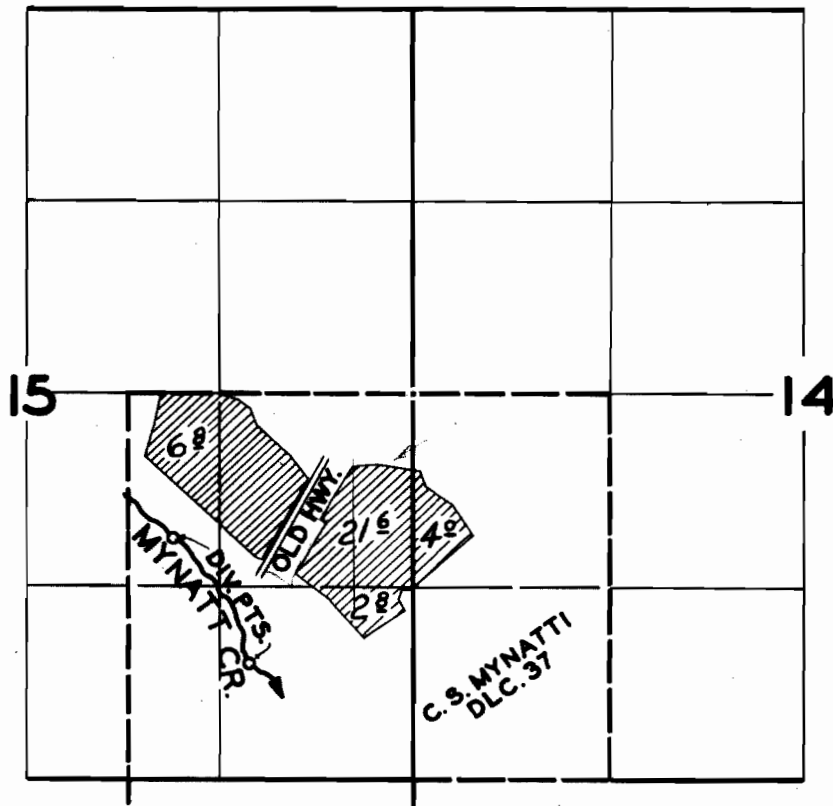

**FINAL PROOF SURVEY**

UNDER

Application No. 30000 Permit No. 23628

IN NAME OF

**LOUIS BRADY**

Surveyed JUNE 20 1957, by *C.D. Smith*