


T.20S.R.3W.W.M.

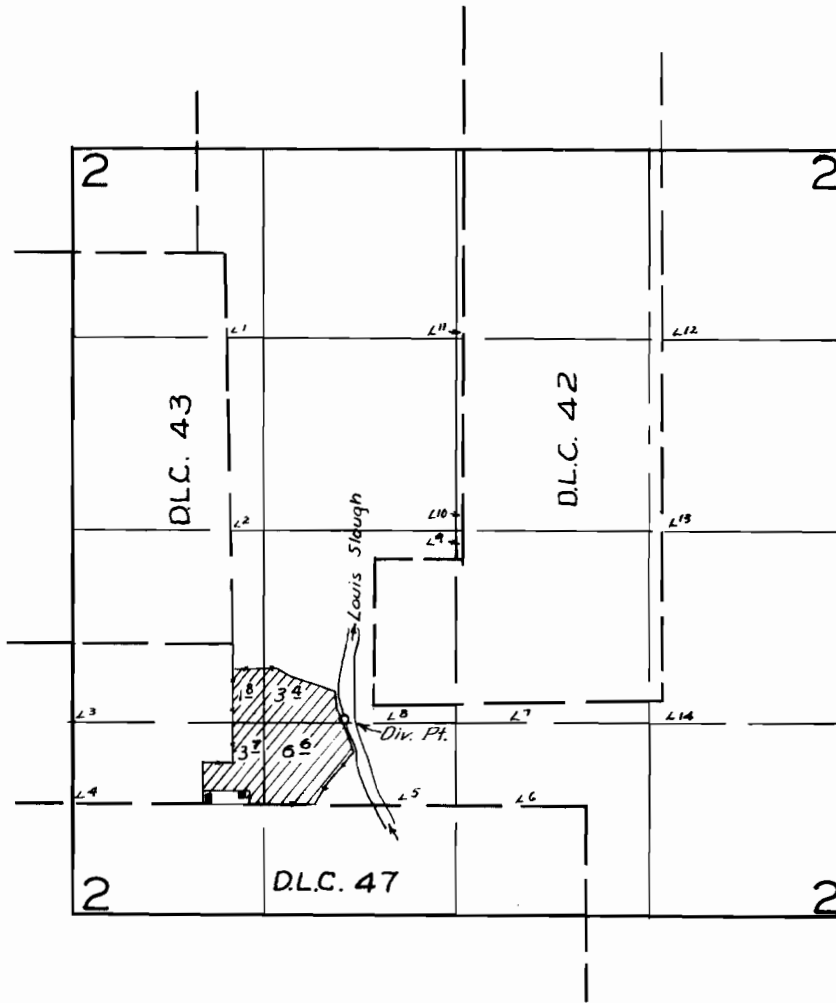

FINAL PROOF SURVEY
UNDER

Application No. 30145... Permit No. 23786..
IN NAME OF

..... Murland G. Johnson

Surveyed April 22 1957, by M. Bish