


T. 19 S. R. 3 W. W. M.

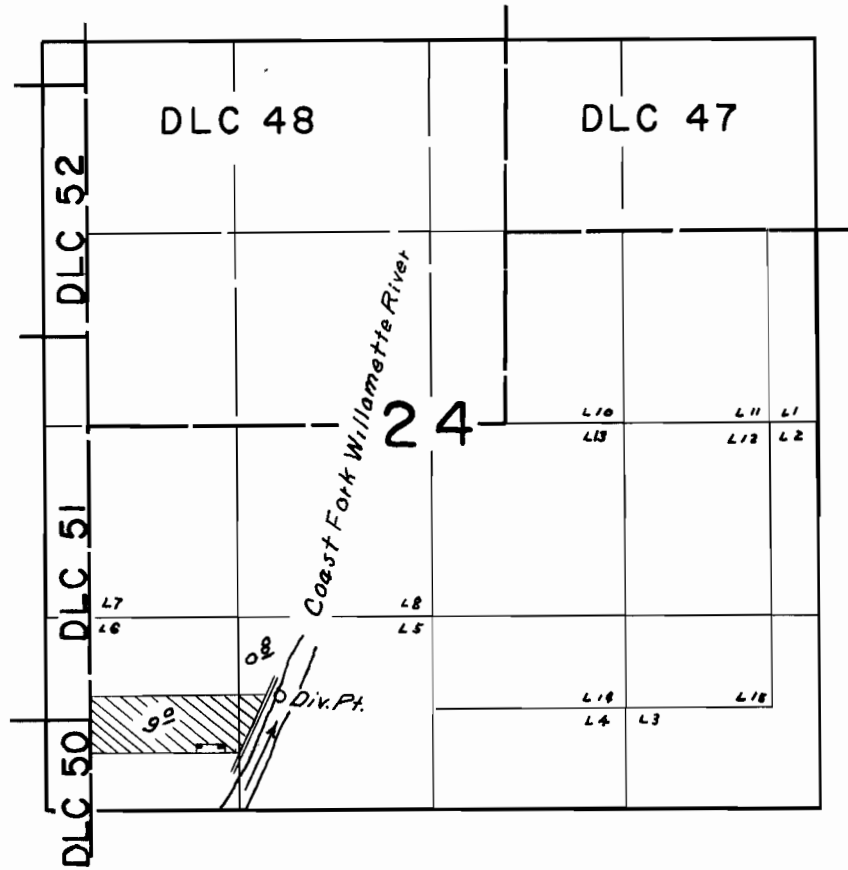

FINAL PROOF SURVEY
UNDER

Application No. 30233... Permit No. 23944...
IN NAME OF

ELLIOT O. & MABLE J. BRAY

Surveyed April 24, 1957, by M. Bish.....