


T.6S.R.1E.W.M.

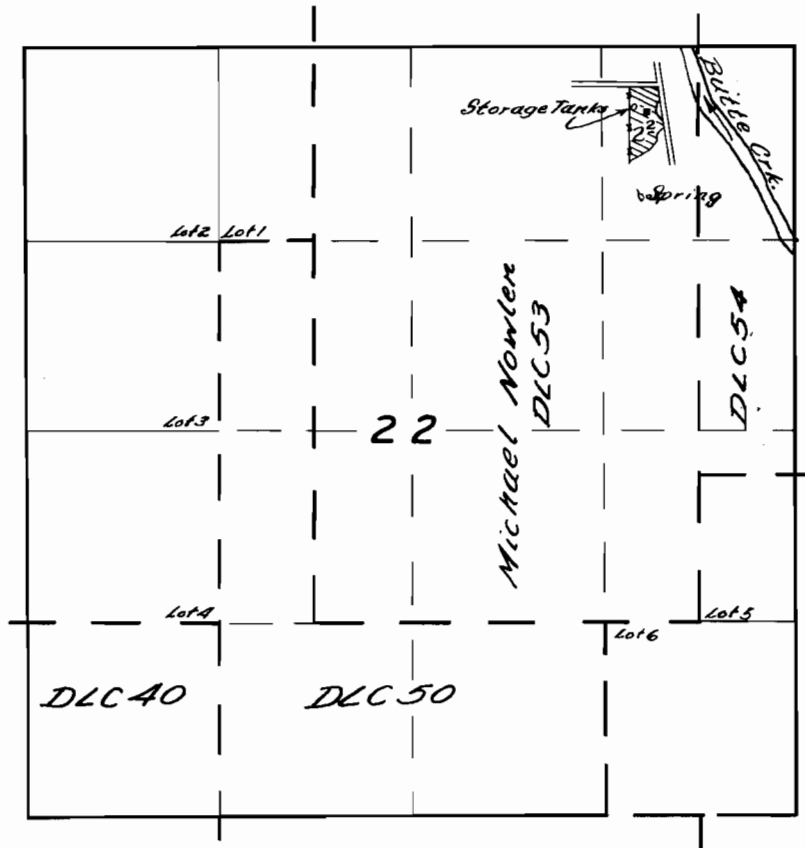

FINAL PROOF SURVEY

UNDER

Application No. 30722. Permit No. 24197.

IN NAME OF

D. P. SLATER

Surveyed MARCH 21 1957, by C. O. BARTELS