


T.16S.R.4W.W.M.

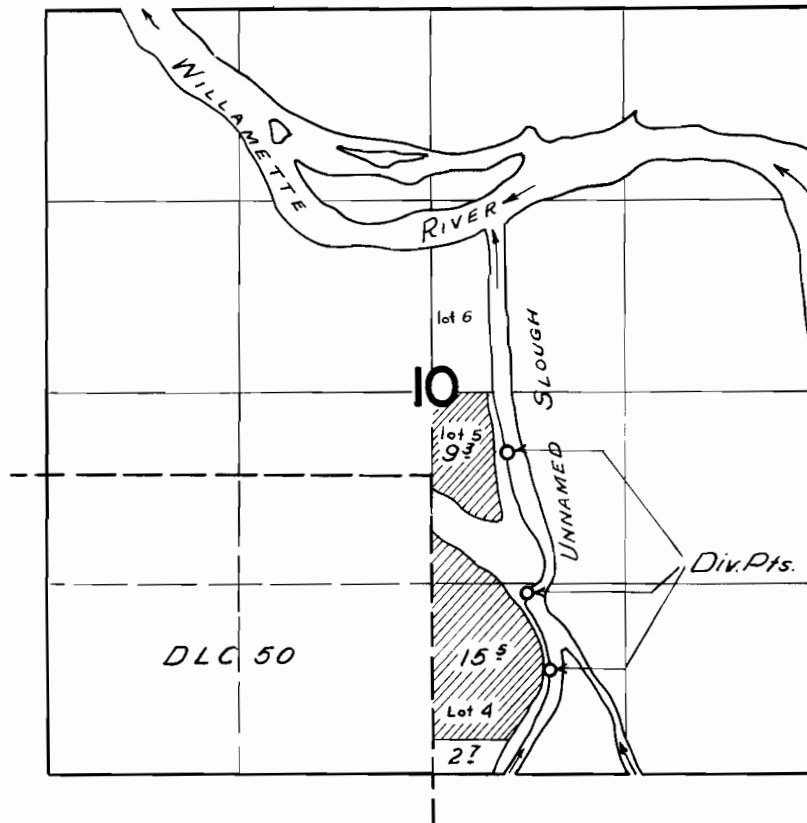

FINAL PROOF SURVEY  
UNDER

Application No. 31014, Permit No. 24452  
IN NAME OF

L. J. ZUMWALT

Surveyed 8 April 1957, by *C. D. Whiteby*