


T. 14 S. R. 15 E. W.M.

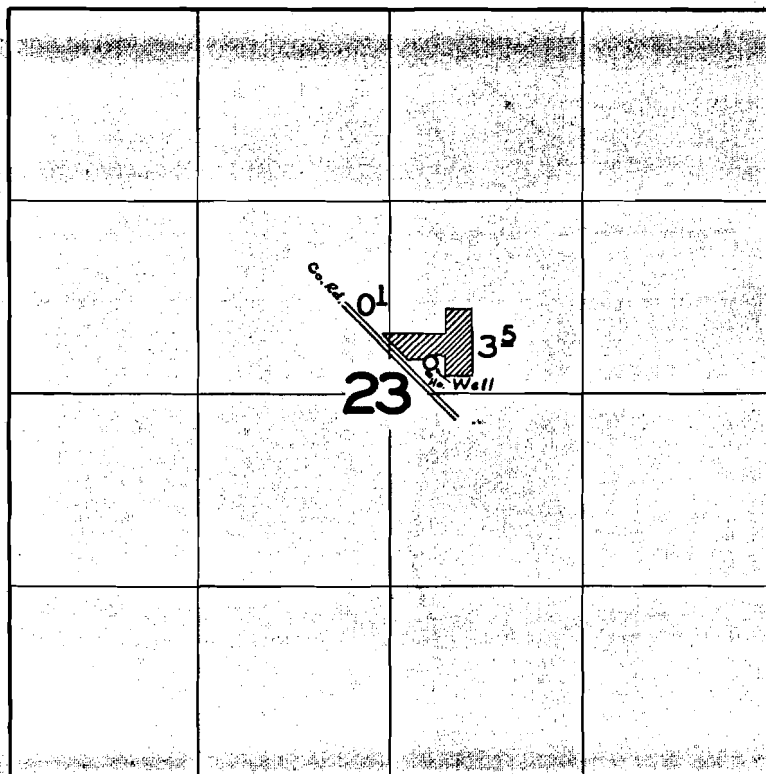

FINAL PROOF SURVEY UNDER

Application No. G-214 Permit No. G-133

IN NAME OF

ERNEST E. FORTNER

Surveyed JULY 31, 1957, by C.O. BARTELS.