


T. 16S. R. 14E. W.M.

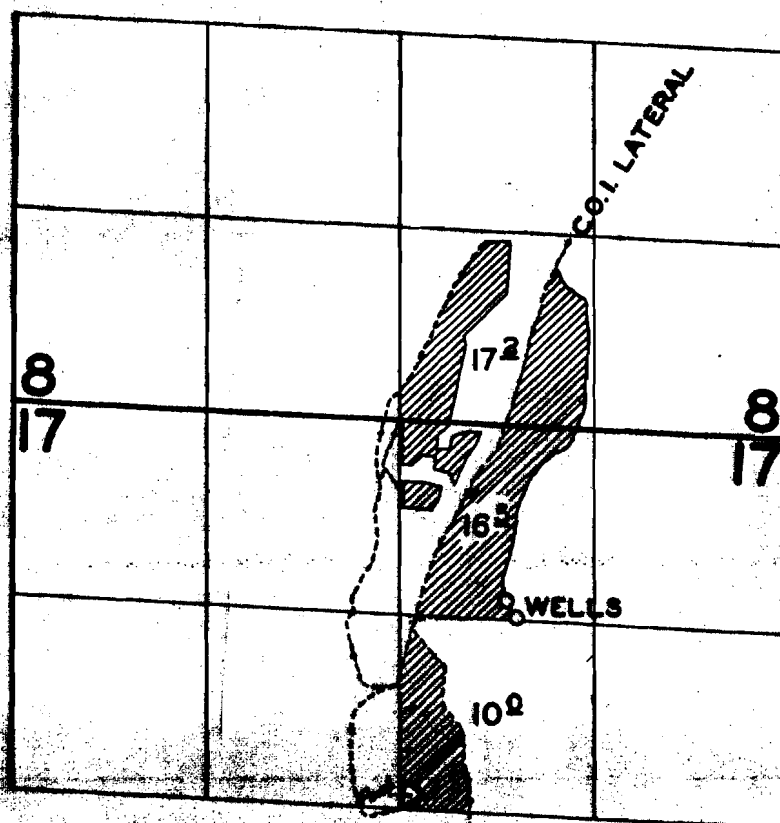

FINAL PROOF SURVEY
UNDER

Application No. U-590 Permit No. U-537

IN NAME OF

ERNST BROTHERS

Surveyed AUG. 4, 1957, by C.O. BARTELS

U-537