


T.9 S.R.2 E.W.W.M.

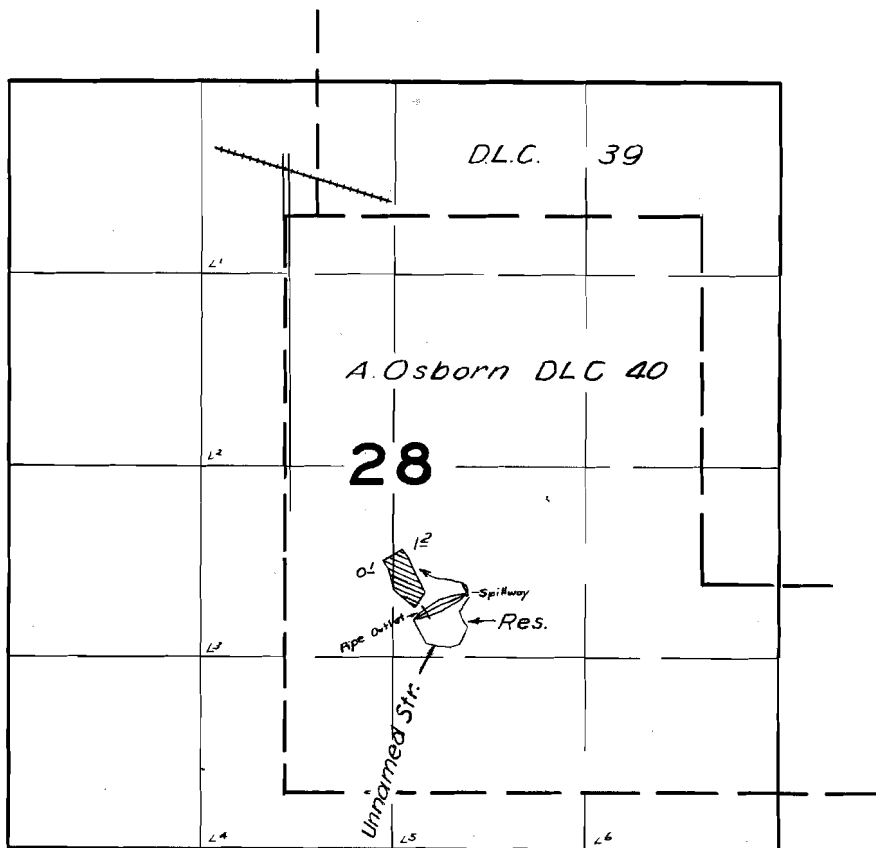

FINAL PROOF SURVEY

UNDER

R-22 867

R-912

Application No. 22868 Permit No. 18051

IN NAME OF

Bernard J. & Barbara Minden

Surveyed Mar. 29, 1957, by Tom Bish