


T. 21 S. R. 3 W. W.M.

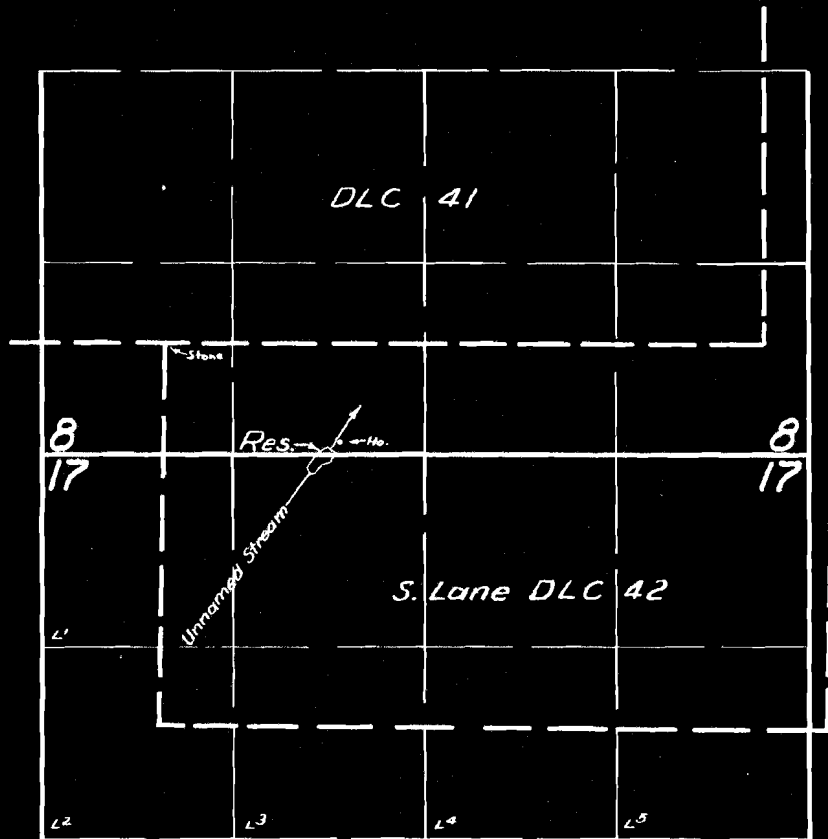

FINAL PROOF SURVEY

UNDER

R-25379

R-1113

Application No. 25091 Permit No. 19949

IN NAME OF

Fred Harris

Surveyed April 8 1957, by *M. Bush*