


T. 5S. R. 2E. W.M.

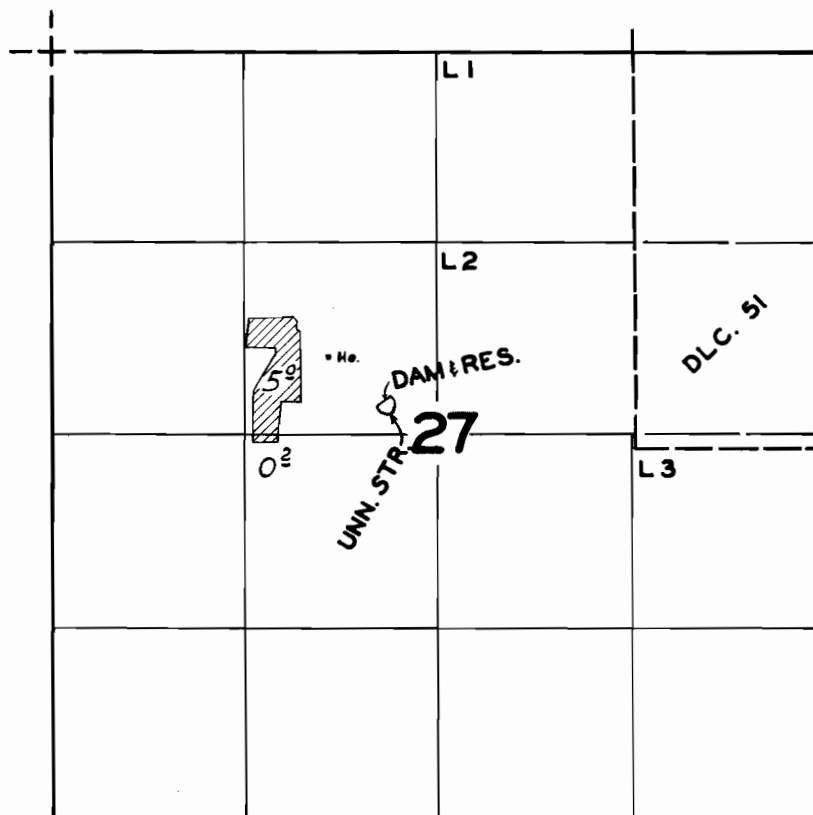

**FINAL PROOF SURVEY**

UNDER

R-24181

R-1121

Application No. 24182 Permit No. 20184

IN NAME OF

**CHARLES W. DAUGHERTY**

Surveyed AUG. 20, 1957, by C.O. BARTELS