


T. 5S. R. 2E. W.M.

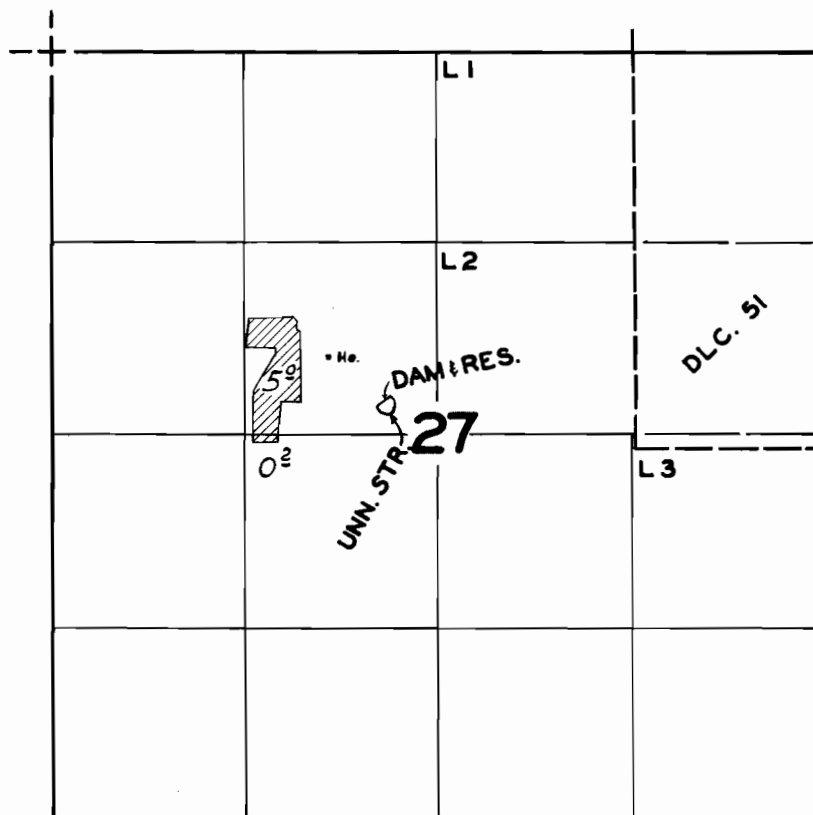

FINAL PROOF SURVEY

UNDER

R-24181

R-1121

Application No. 24182 Permit No. 20184

IN NAME OF

CHARLES W. DAUGHERTY

Surveyed AUG. 20, 1957, by C.O. BARTELS