


T. 34 S. R. 2 W. W.M.

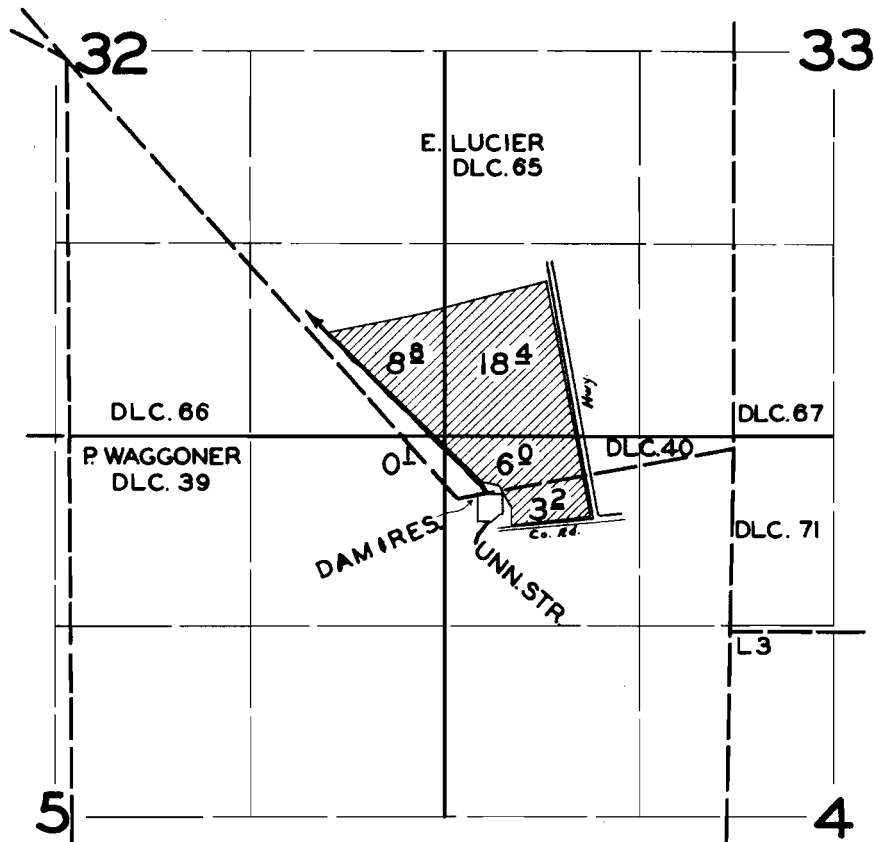

FINAL PROOF SURVEY

UNDER

R-25925

R-1214

Application No. 25926 .. Permit No. 20542.

IN NAME OF

REINHOLD WAHL

Surveyed MAR.25. 1957. by C.O.BARTELS.