


T. 34 S. R. 2 W. W.M.

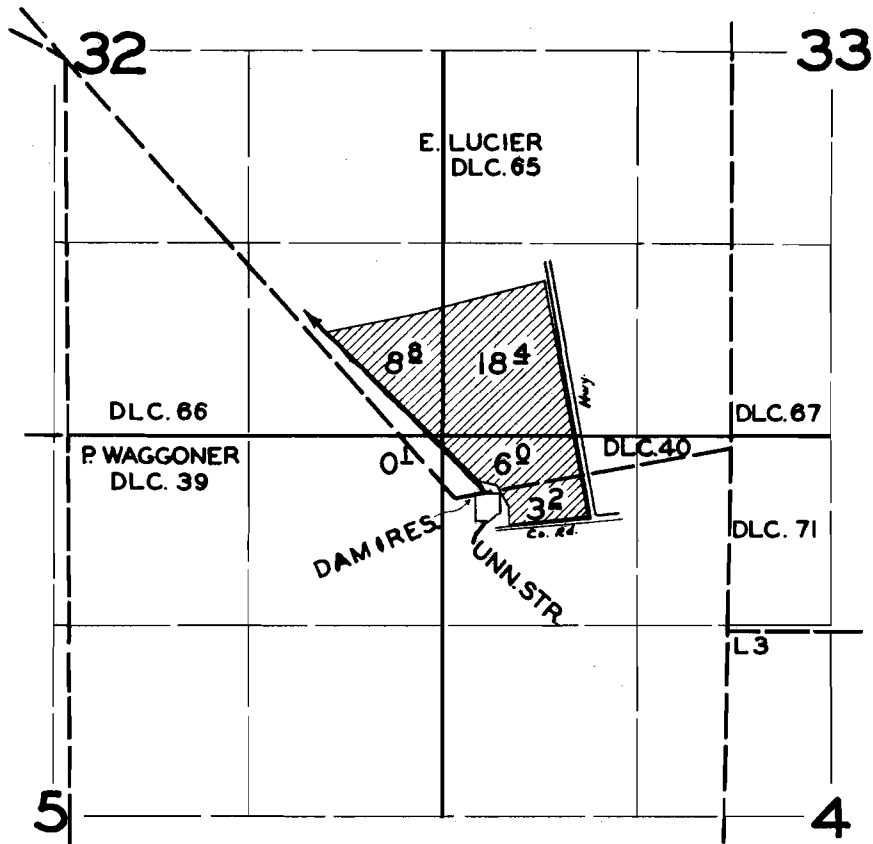

FINAL PROOF SURVEY

UNDER

R-25925

R-1214

Application No. 25926 Permit No. 20542

IN NAME OF

REINHOLD WAHL

Surveyed MAR. 25, 1957, by C.O. BARTELS.