


T. 29S. R. 8W. W.M.

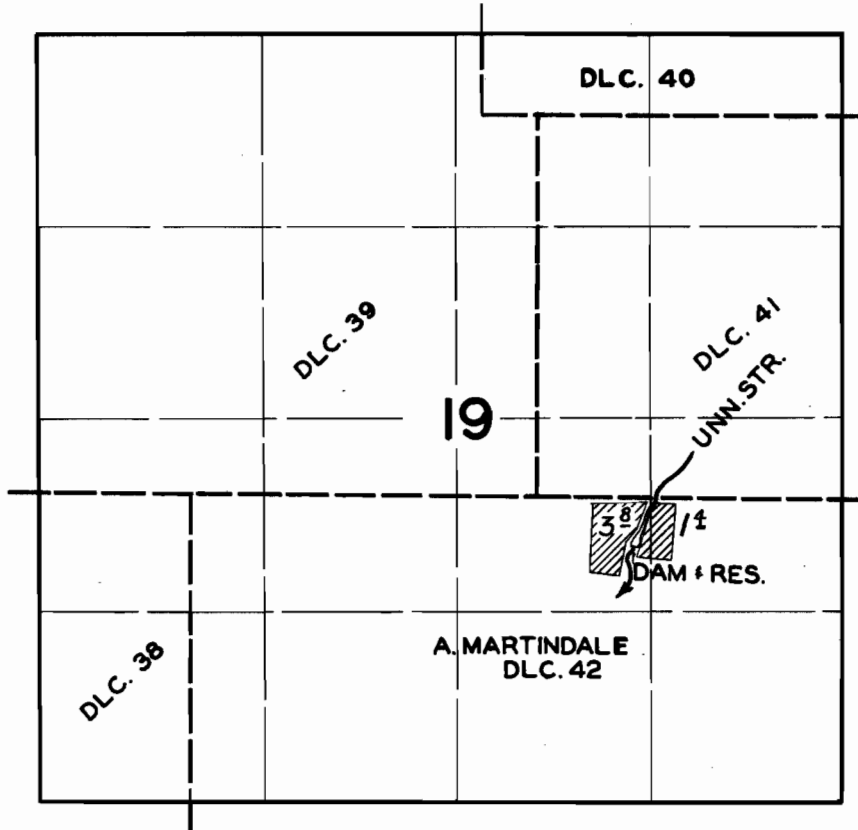

**FINAL PROOF SURVEY**

UNDER

R-26576 R-1271  
Application No. 26442 Permit No. 20734

IN NAME OF

JAMES & WELCOME M. COMBS

Surveyed AUG. 28. 1956, by C.O. BARTELS