


T. 29S. R. 8W. W.M.

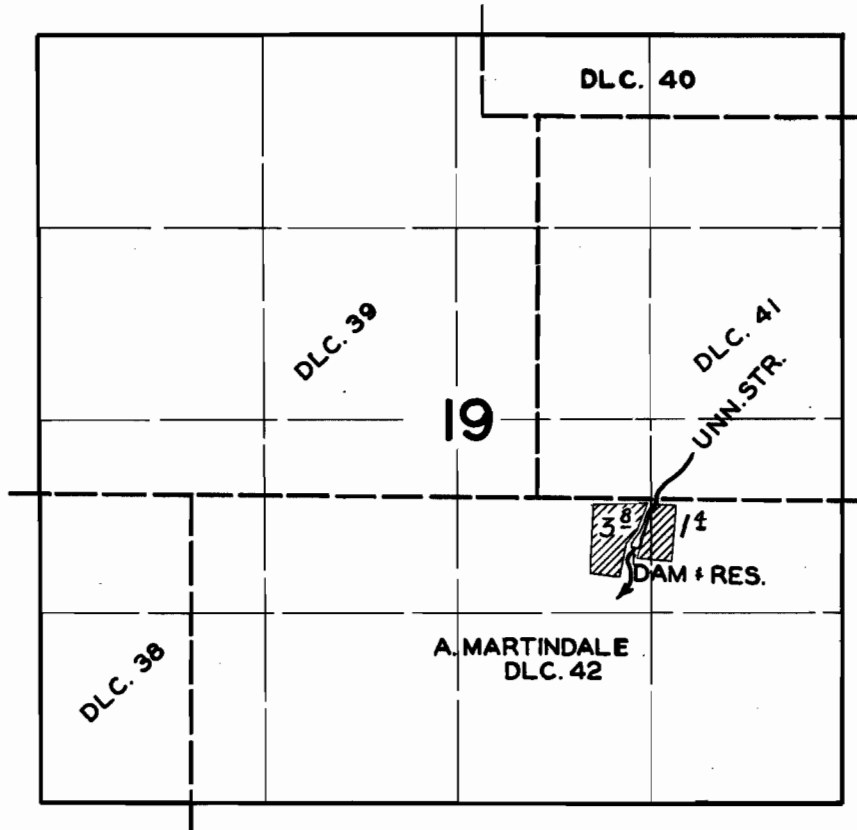

FINAL PROOF SURVEY

UNDER

R-26576

R-1271

Application No. 26442 Permit No. 20734..

IN NAME OF

JAMES & WELCOME M. COMBS

Surveyed AUG. 28. 1956. by C.O. BARTELS