


T.20 S.R.3 W.W.M.

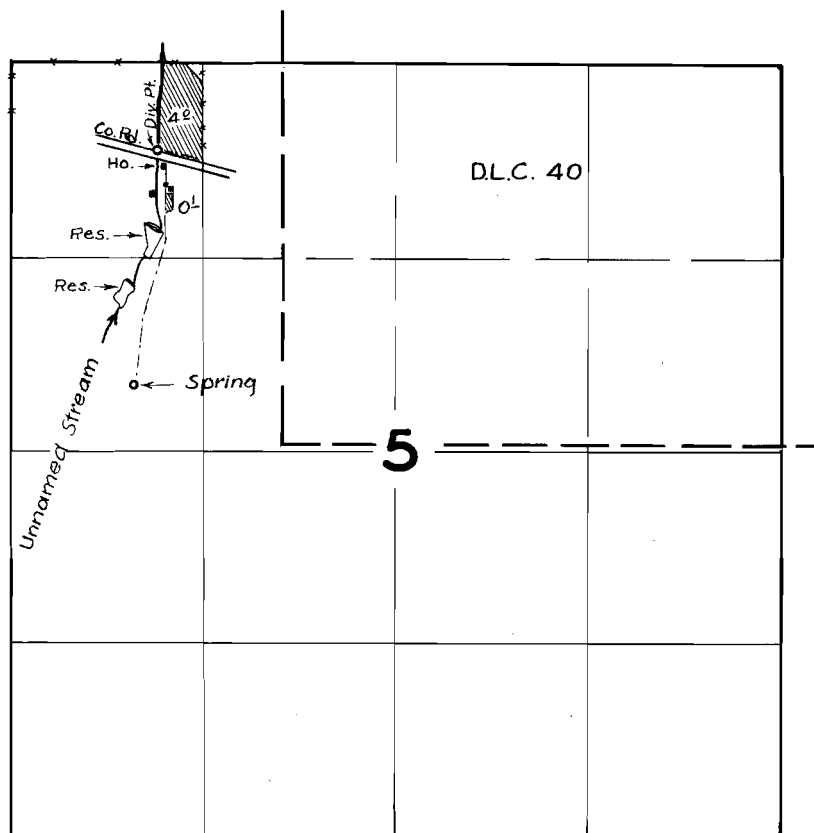

FINAL PROOF SURVEY

UNDER

R-27992

R-1473

Application No. 27993 Permit No. 22032

IN NAME OF

Loyd J. & Alvin M. Eppenbaugh

Surveyed April 18 1957, by Tom Bish