


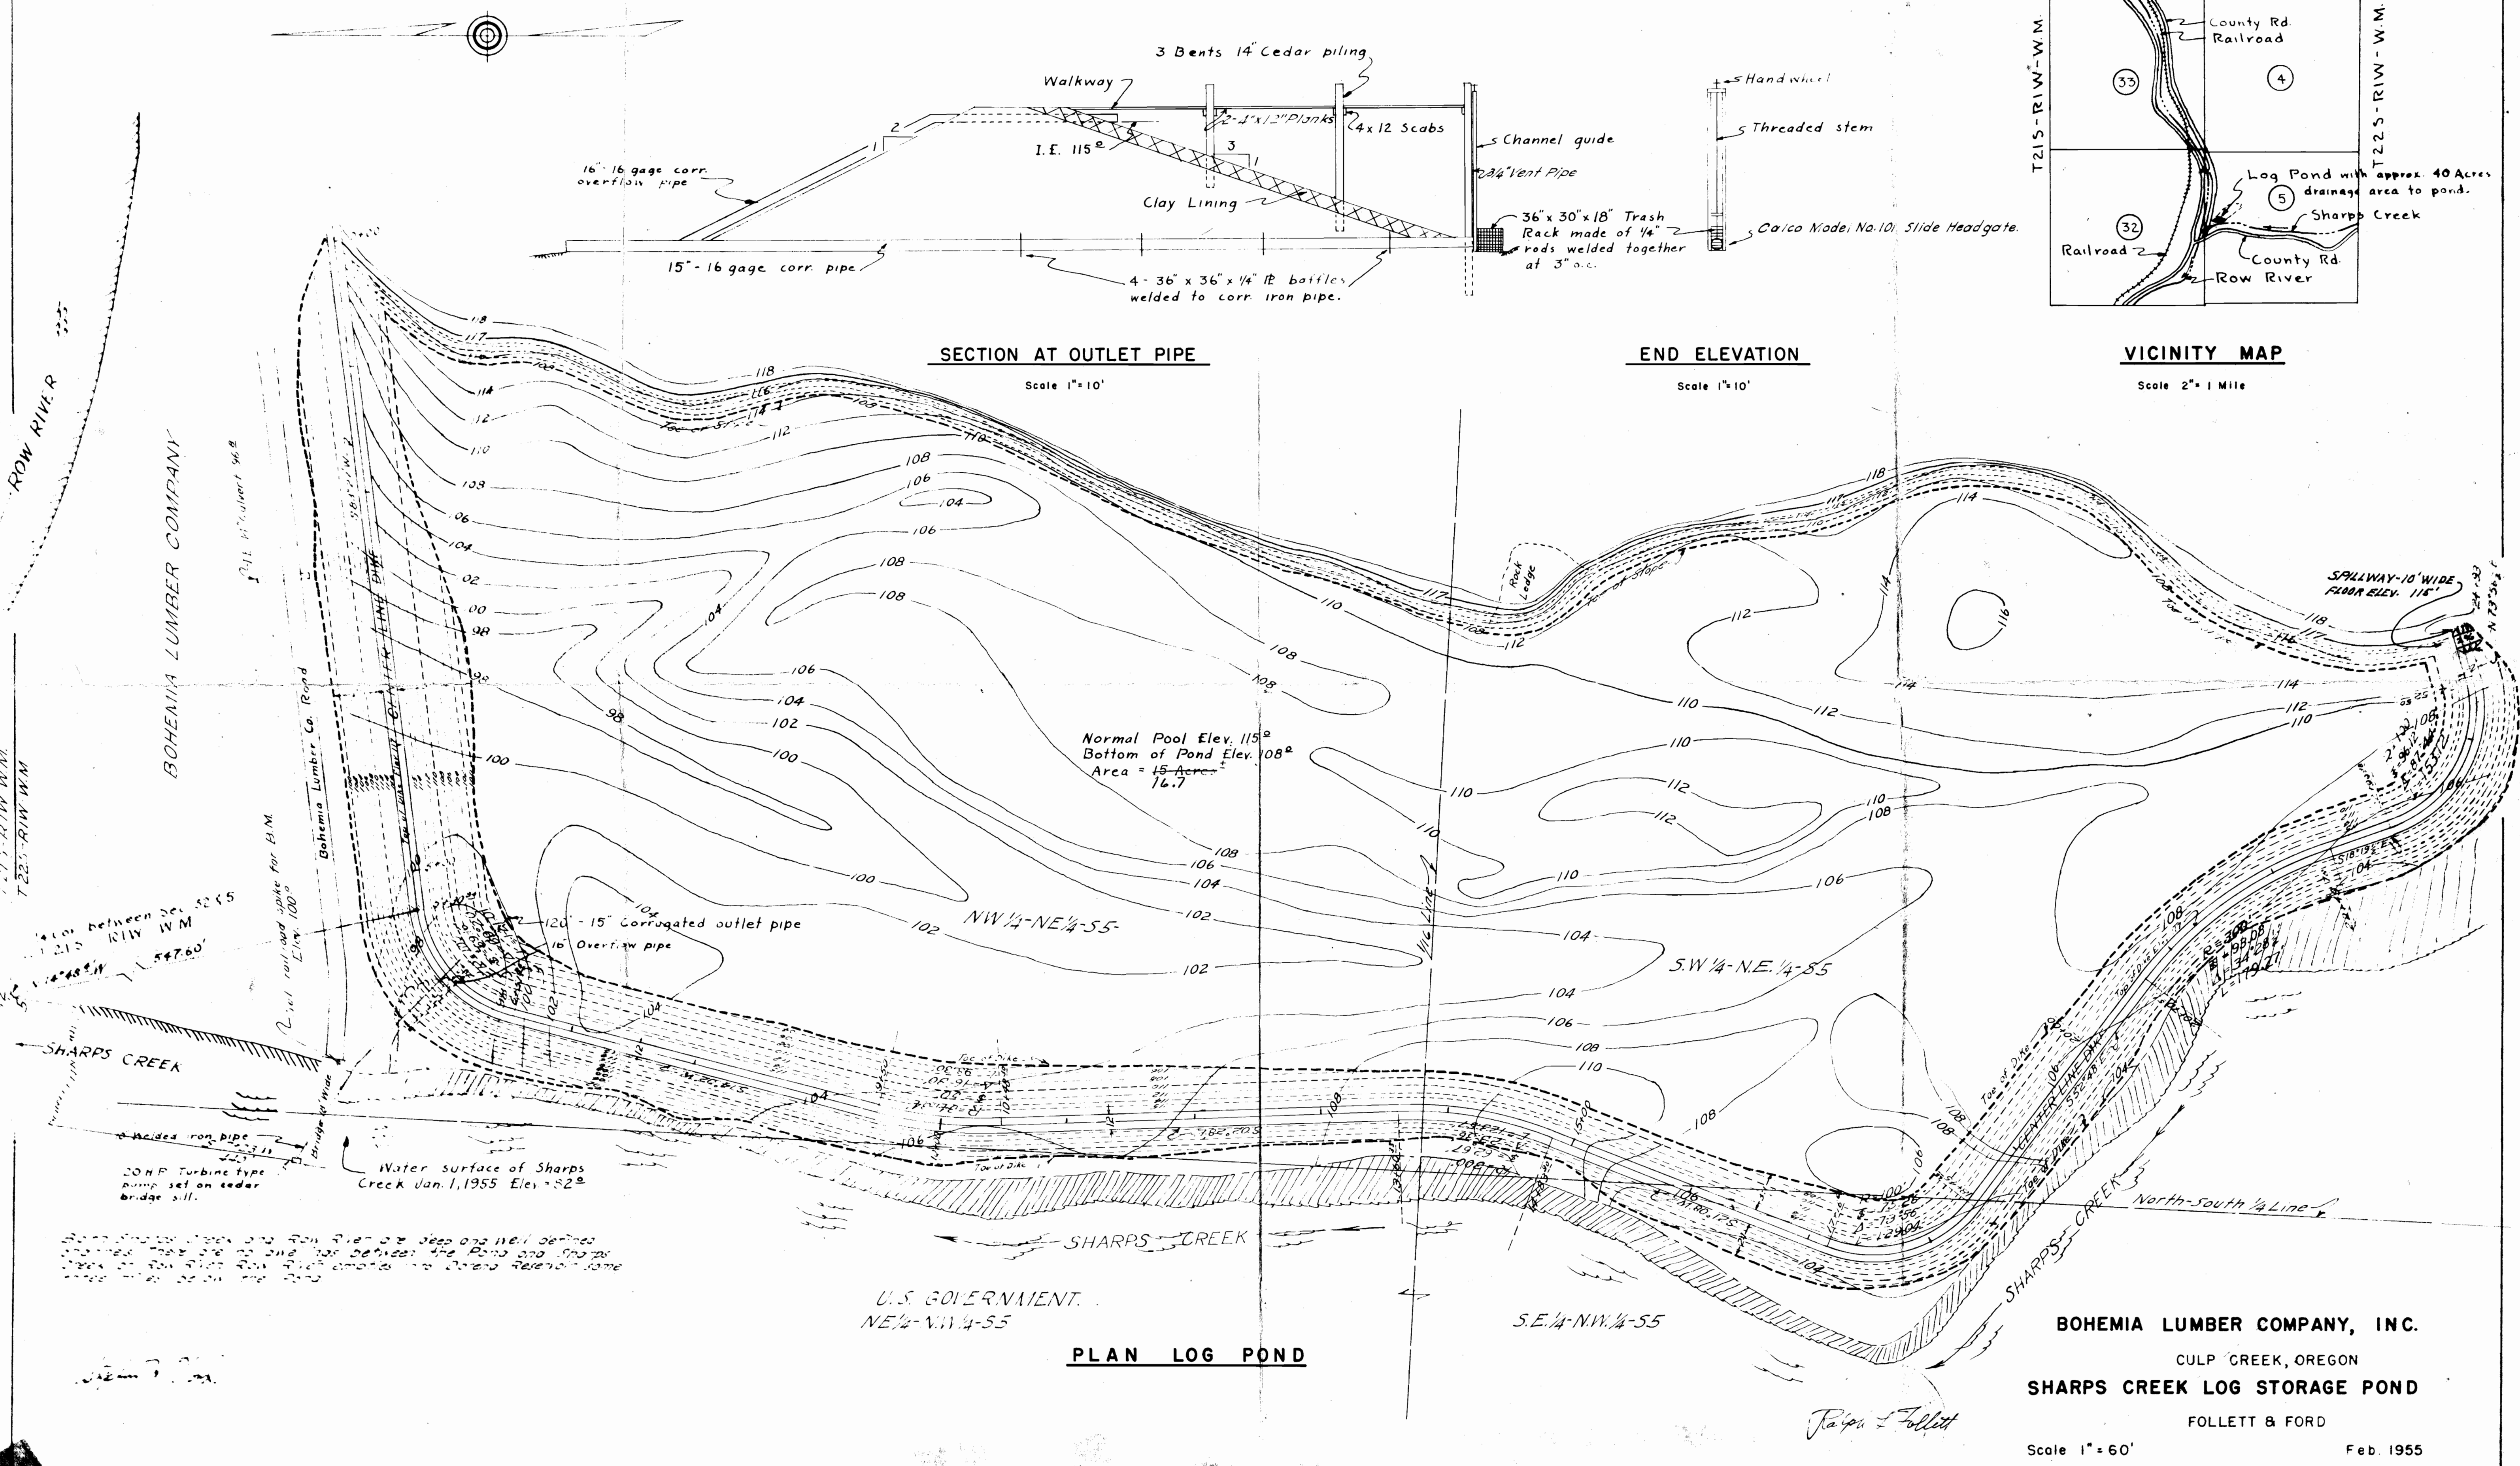

SECTION AT OUTLET PIPE

Scale 1" = 10'

END ELEVATION

Scale 1" = 10'

VICINITY MAP

Scale 2" = 1 Mile

U.S. GOVERNMENT.
NE 1/4 - NW 1/4 - S5

PLAN LOG POND

BOHEMIA LUMBER COMPANY, INC.
CULP CREEK, OREGON
SHARPS CREEK LOG STORAGE POND

FOLLETT & FORD

Scale 1" = 60'

Feb. 1955

REVISED (SPILLWAY SHOWN)
(TRACING IN FILE 306593)

SHEET 1 OF 2 SHEETS
Job # 51619