


T. 2N. R. 10E. W.M.

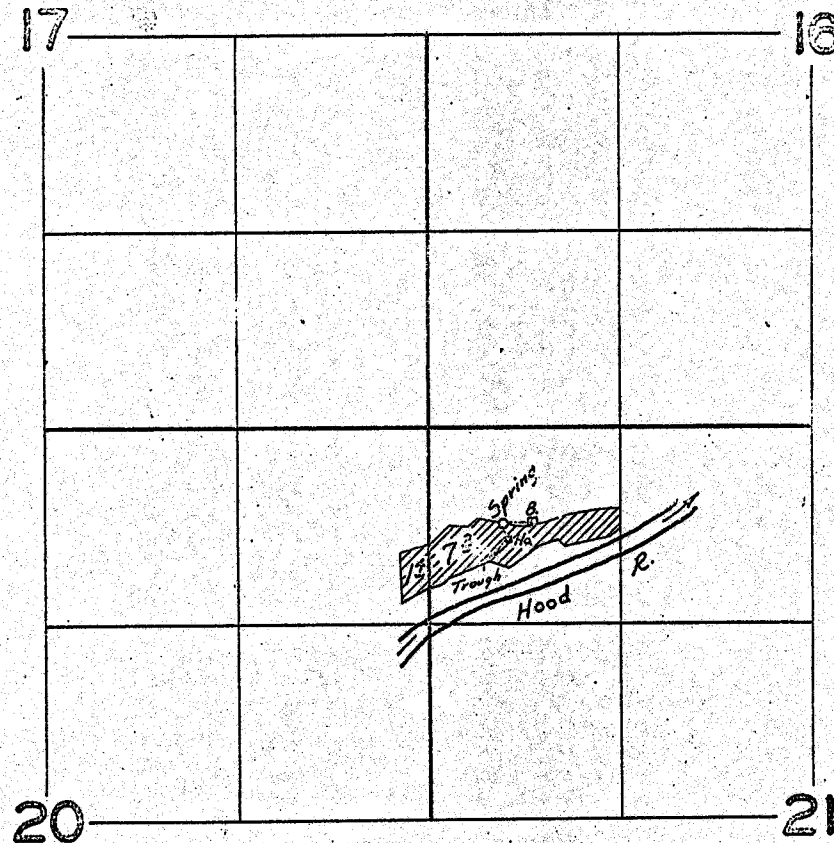

FINAL PROOF SURVEY
UNDER

Application No. 21202 Permit No. 16619
IN NAME OF

RUSSELL RAYOT

Surveyed Apr. 25 1957, by C.O. Bartel