


T. 30S. R. 3&4W. W.M.

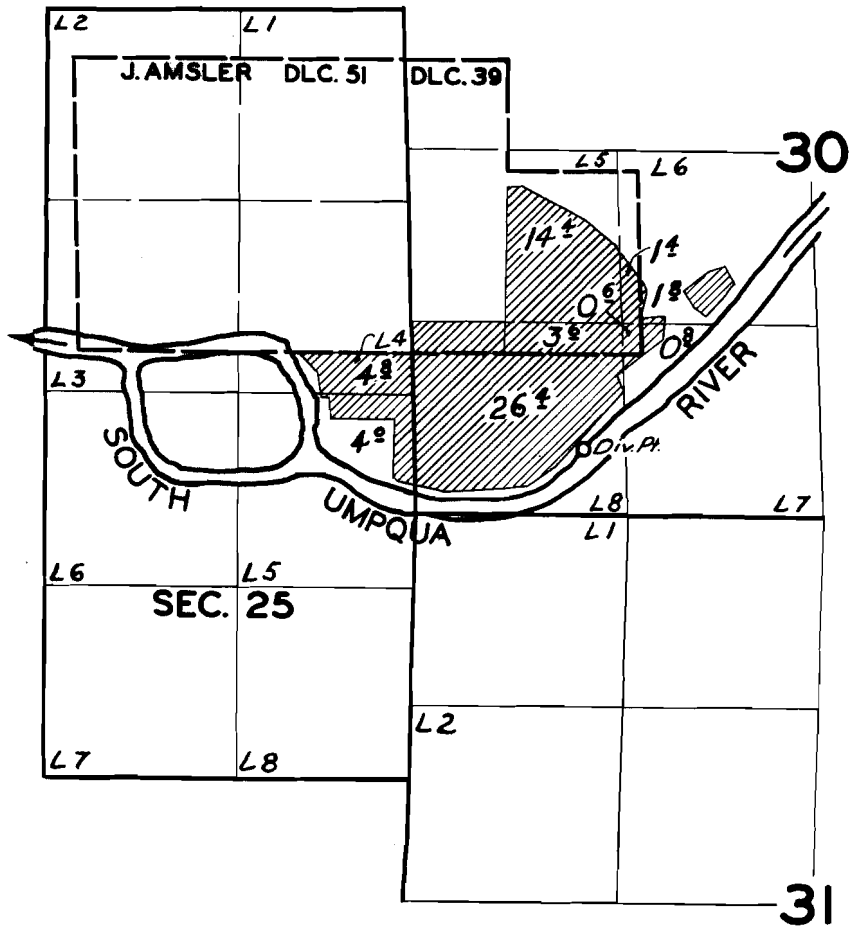

FINAL PROOF SURVEY
UNDER

Application No. 22235. Permit No. 17542.
IN NAME OF

J. R. RITTER

Surveyed JUNE 24 1957, by *C. O. Burtch*