


T.16S.R.6W.W.M.

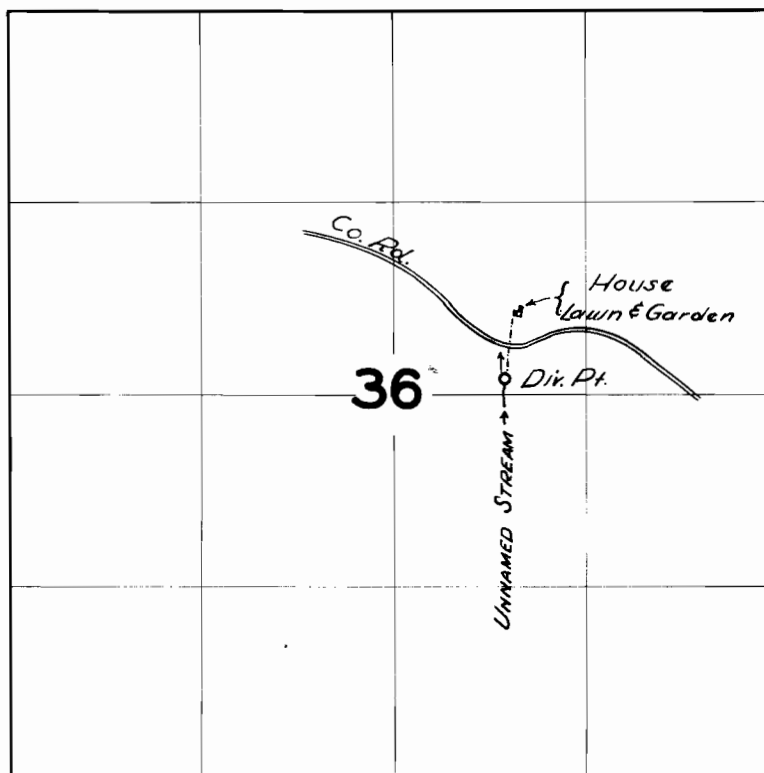

FINAL PROOF SURVEY
UNDER

Application No. 22409 Permit No. 17664

IN NAME OF

GEORGE A. & AGNES J. SARGENT

Surveyed 12 April 1957, by C. A. White