


T. 9 S. R. 1 W. W. M.

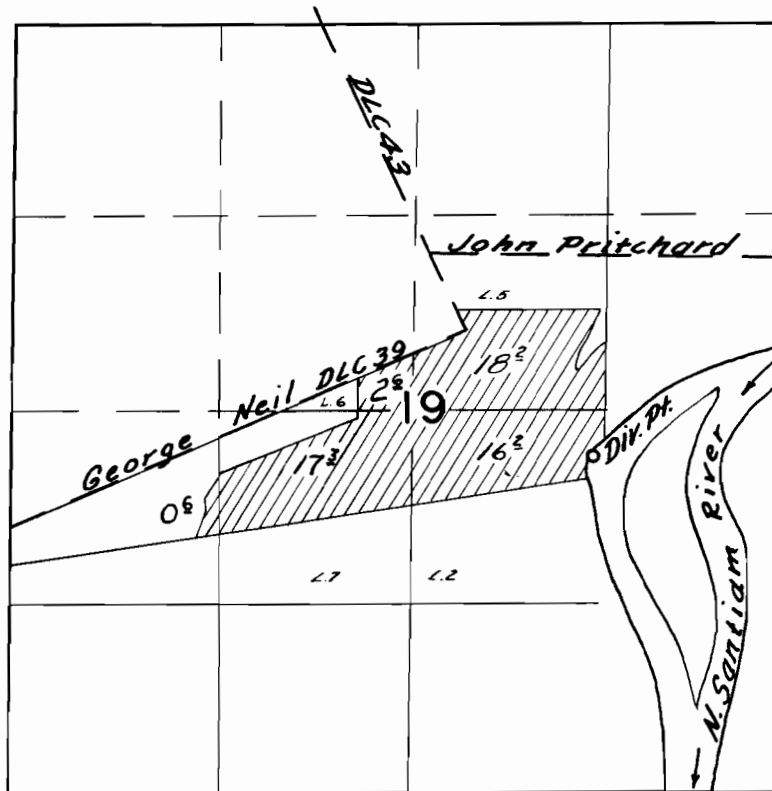

FINAL PROOF SURVEY

UNDER

Application No. *22531* .. Permit No. *18018*..

IN NAME OF

C. L. Stanley & Anna E. Stanley ..

Surveyed *May 16* 1956, by *R. H. Whitby*..

DFN-20-125