


T. 2N. R. 10E. W.M.

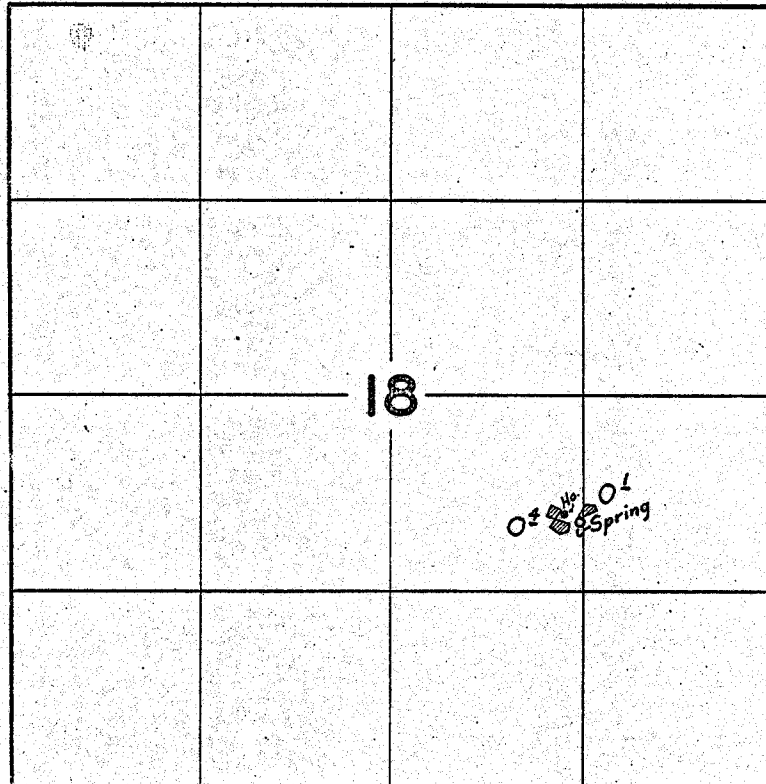

**FINAL PROOF SURVEY**  
UNDER

Application No. 23437. Permit No. 18499.  
IN NAME OF

.....JAMES ISHIZAKA.....

Surveyed APR. 26. 1957., by *C. O. Suetels*