


# T.9 S.R.I W.W.M.

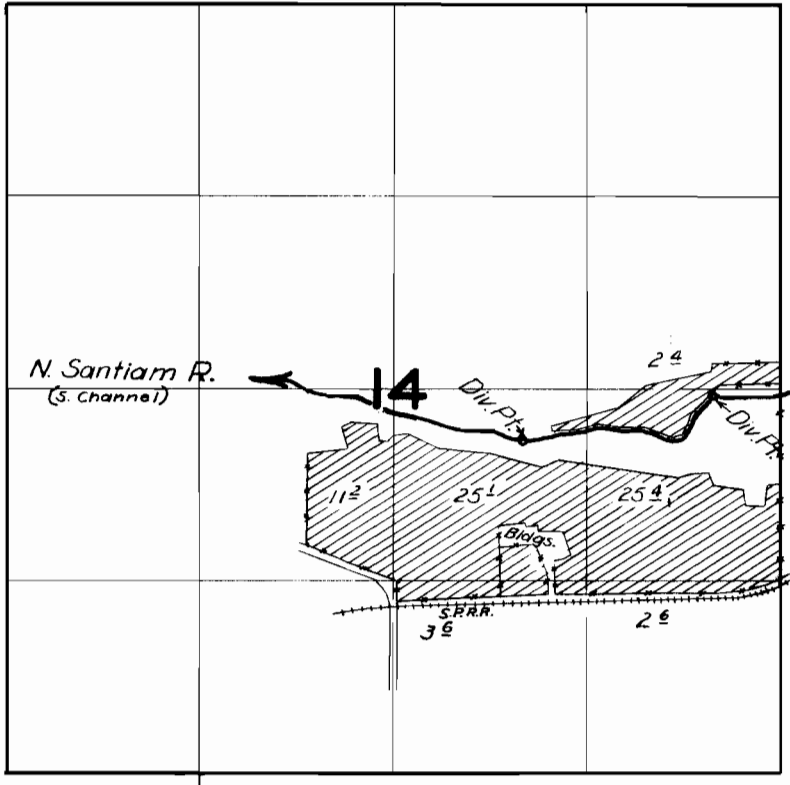

## FINAL PROOF SURVEY

UNDER

Application No. 23077 Permit No. 18062

IN NAME OF

*Lester W. Hagel*

Surveyed *Mar. 28* 1957, by *Tom Bish*