


2295

T.19 S.R.3 W.W.M.

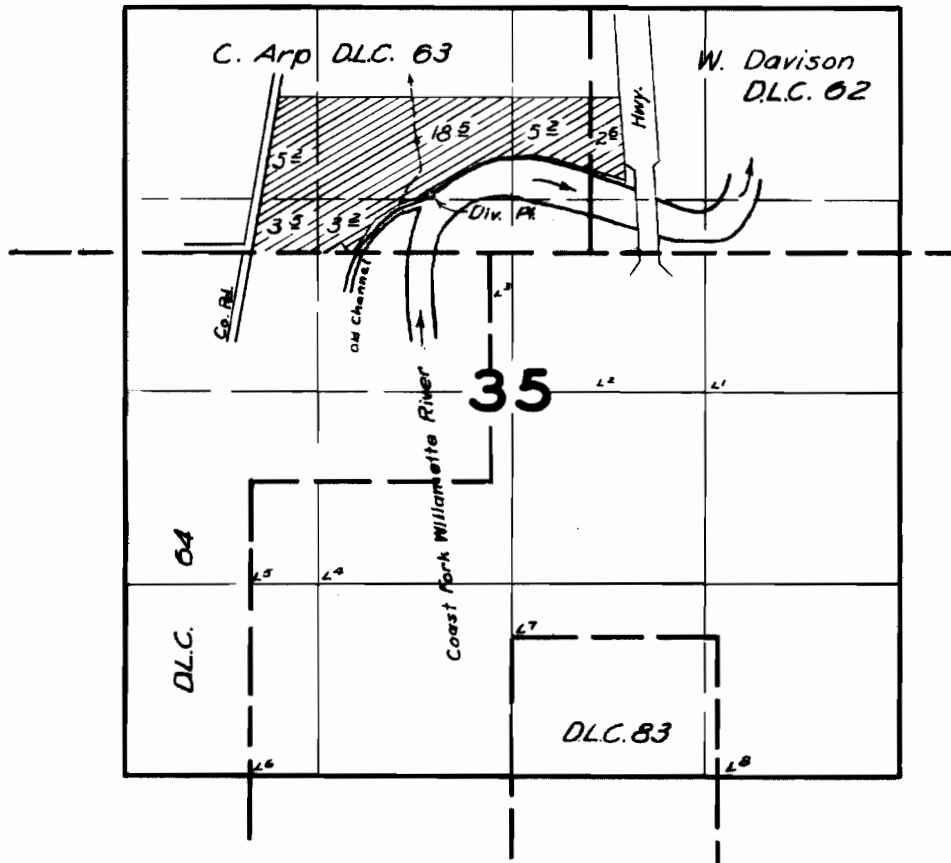

FINAL PROOF SURVEY UNDER

Application No. 23821 Permit No. 18887
IN NAME OF

Miles S. & Frances Evelyn Quinn

Surveyed April 25, 1957, by T.M. Bick

6-1-49