


T. 21 S. R. 3 W. W. M.

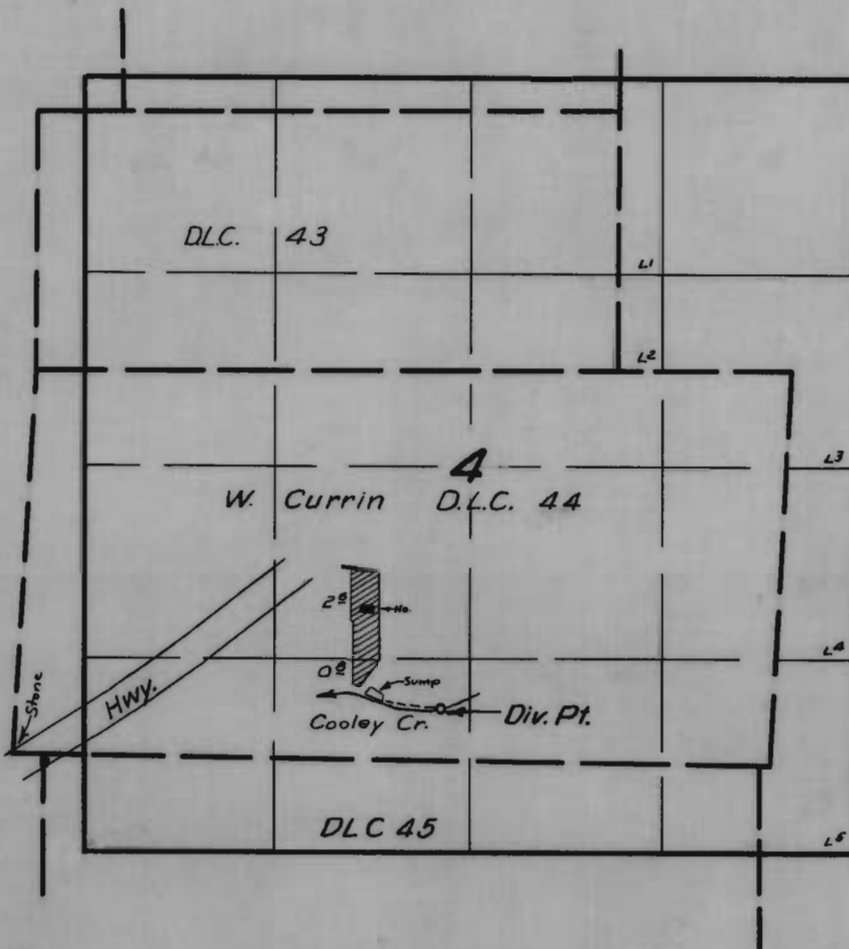

FINAL PROOF SURVEY

UNDER

Application No. 24068 Permit No. 18960

IN NAME OF

Cecil E. Caldwell

Surveyed April 9 1957, by Tr. Bish