


T. 8 S. R. 47 E. W. M.

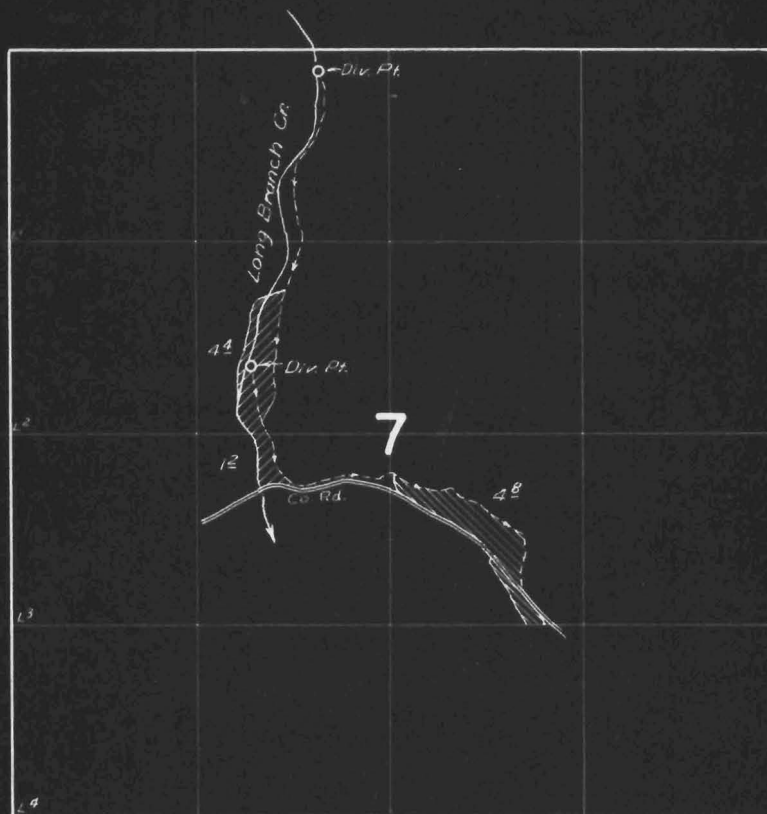

FINAL PROOF SURVEY

UNDER

Application No. 17346 24321 Permit No. 13141 19065

IN NAME OF

J. J. Hendrix

Surveyed Oct. 18, 1956, by M. Bish