


T.14S.R.5W.W.M.

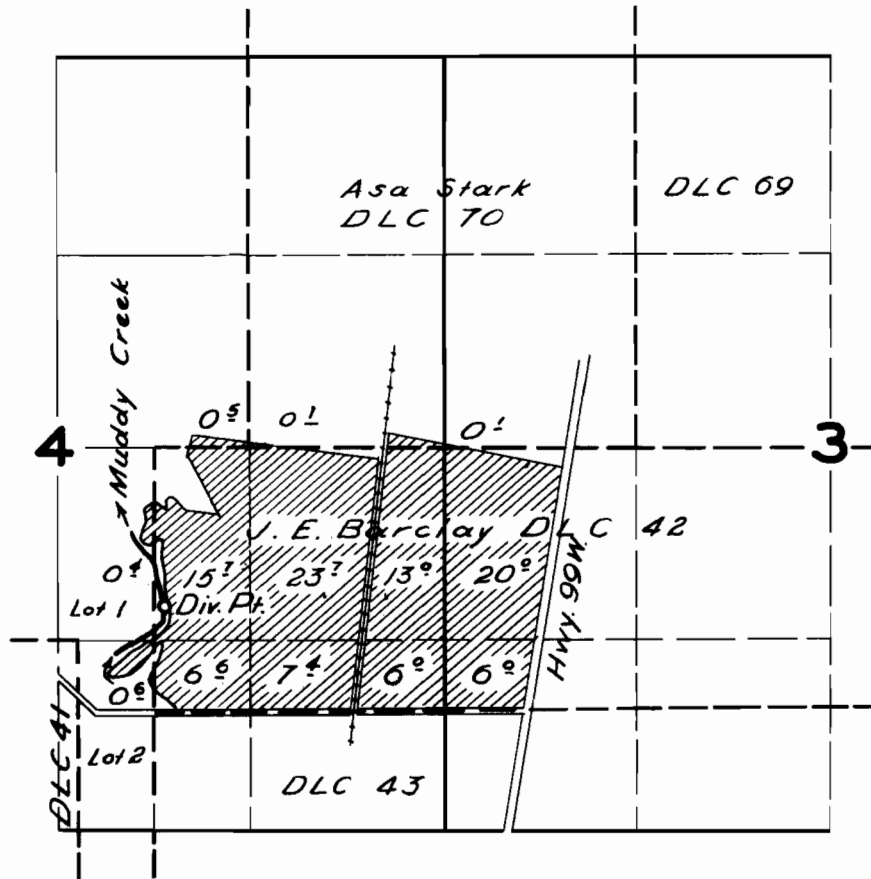

FINAL PROOF SURVEY

UNDER

Application No. 23977 Permit No. 19188

IN NAME OF

E. F. HUBBARD

Surveyed 24 Apr. 1957, by [Signature]