


T. 4S. R. IW. W.M.

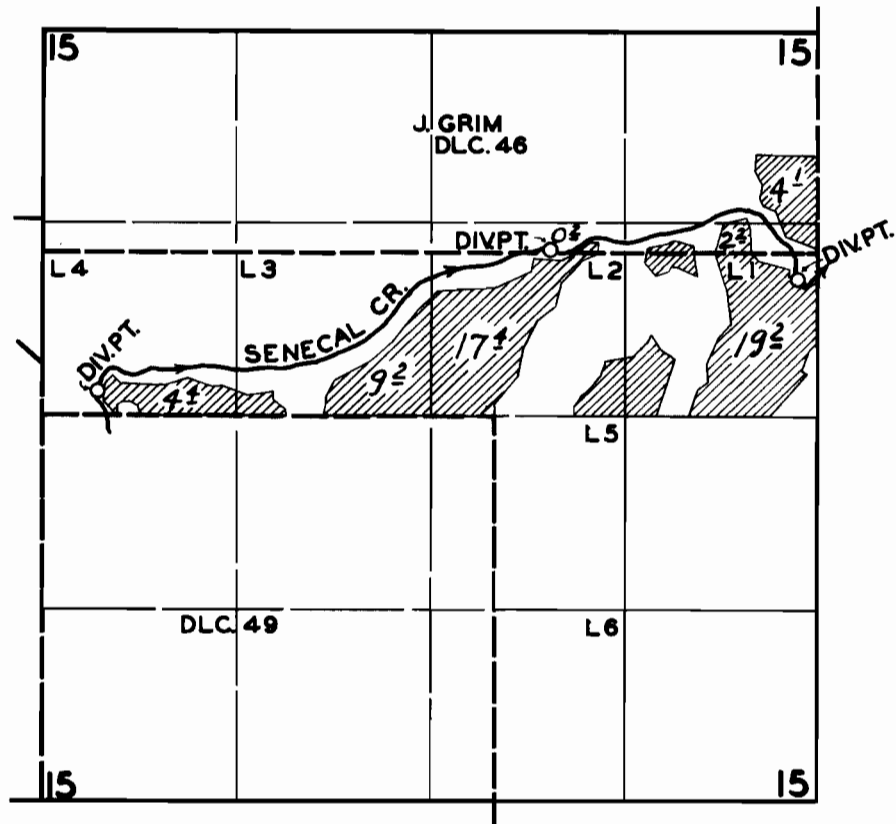

FINAL PROOF SURVEY

UNDER

Application No. 24054 Permit No. 19196

IN NAME OF

EMIL ZWICKER

Surveyed AUG. 19, 1957, by C.O. BARTELS