


T.19 S.R.4 W.W.M.

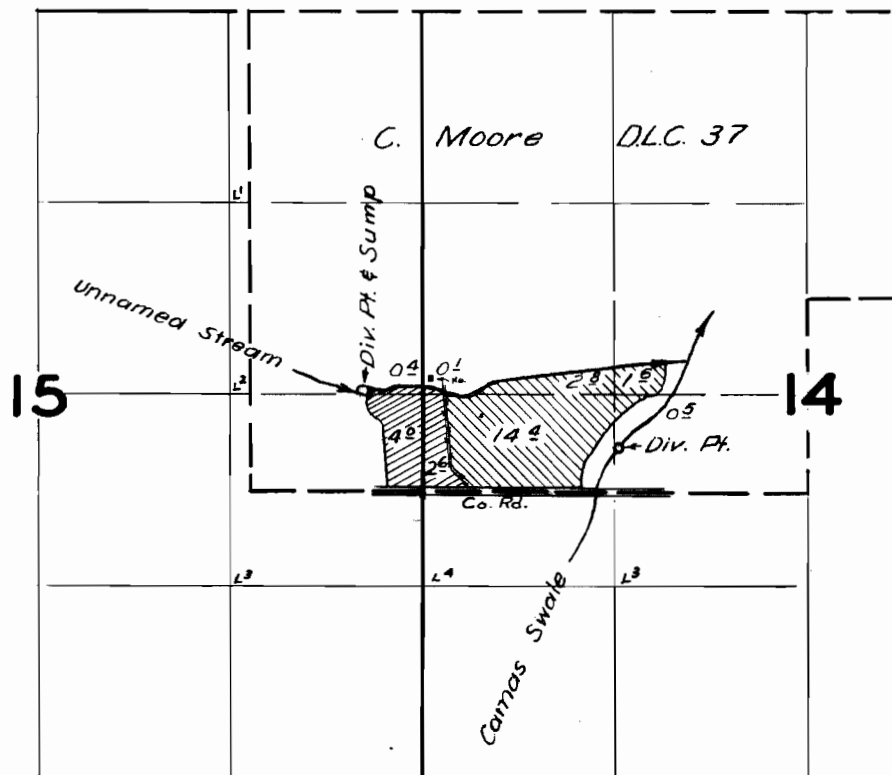

FINAL PROOF SURVEY
UNDER

Application No. 24258 Permit No. 19213
IN NAME OF

Kaikilani Kamakana Robinson Walsh

Surveyed April 26, 1957, by M. A. Bish