


T. 16 S. R. 6 W. W.M.

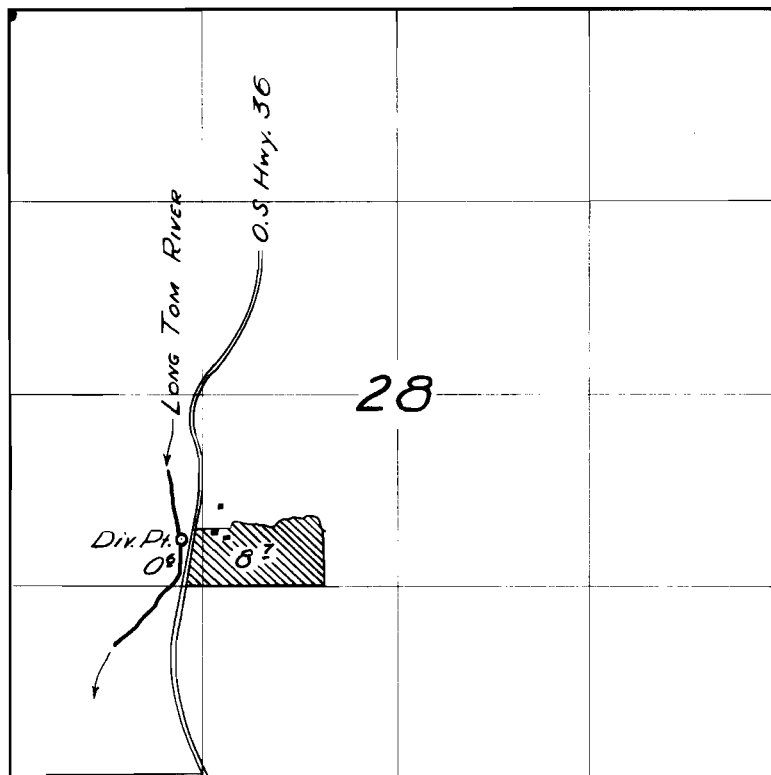

FINAL PROOF SURVEY
UNDER

Application No. 24795 Permit No. 19531
IN NAME OF

RALPH A. & HELEN CAMPBELL

Surveyed 13 May 1957, by *[Signature]*