


T.20 S.R.3 W.W.M.

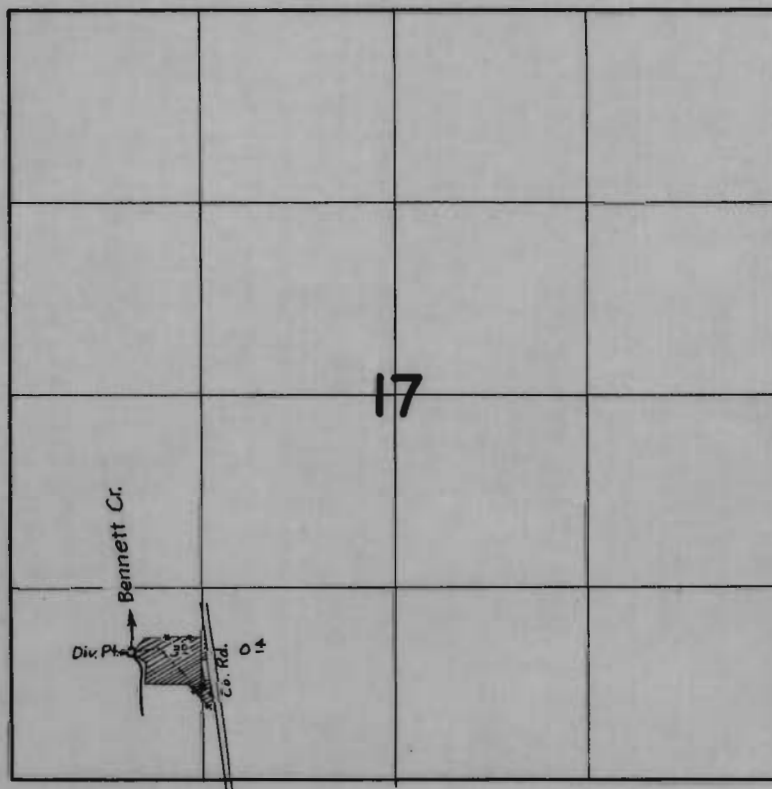

FINAL PROOF SURVEY
UNDER

Application No. 24851..... Permit No. 19558.....
IN NAME OF

.....Delmar Benston.....

Surveyed April 22 1957, by Tom Bish.....