


T. 14S. R. 15E. W.M.

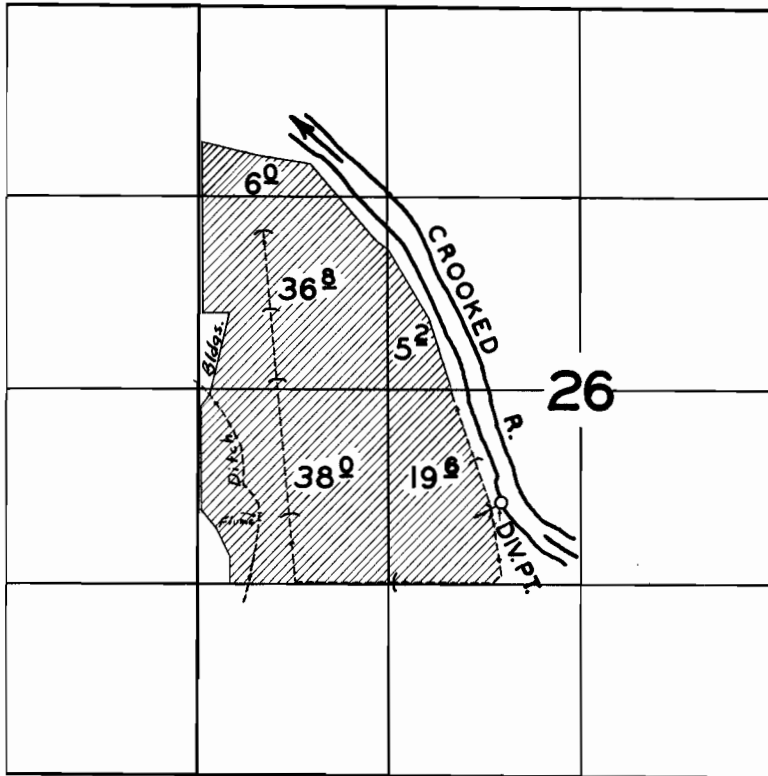

FIELD PROOF SURVEY
UNDER

Application No. 25184. Permit No. 19956.
IN NAME OF

EARL FOREST

Surveyed AUG. 4, 1957, by C.O. BARTELS