


T.16S.R.6W.W.M.

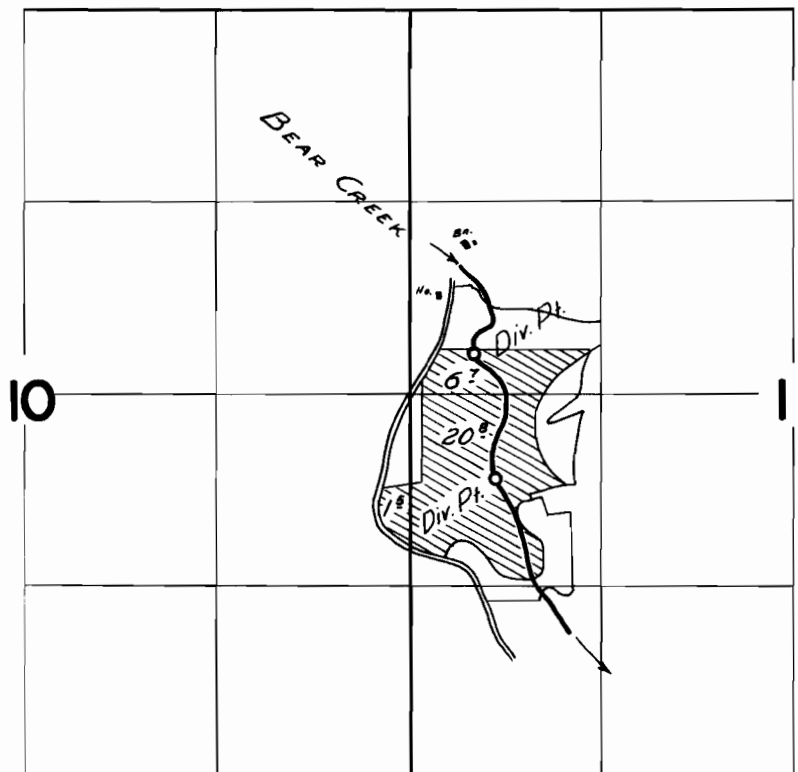

FINAL PROOF SURVEY
UNDER

Application No. 25654 Permit No. 20119
IN NAME OF

WM. GERALD TEMPLETON

Surveyed 15 April 1957, by CAH