


T. 32S. R. 6W. W.M.

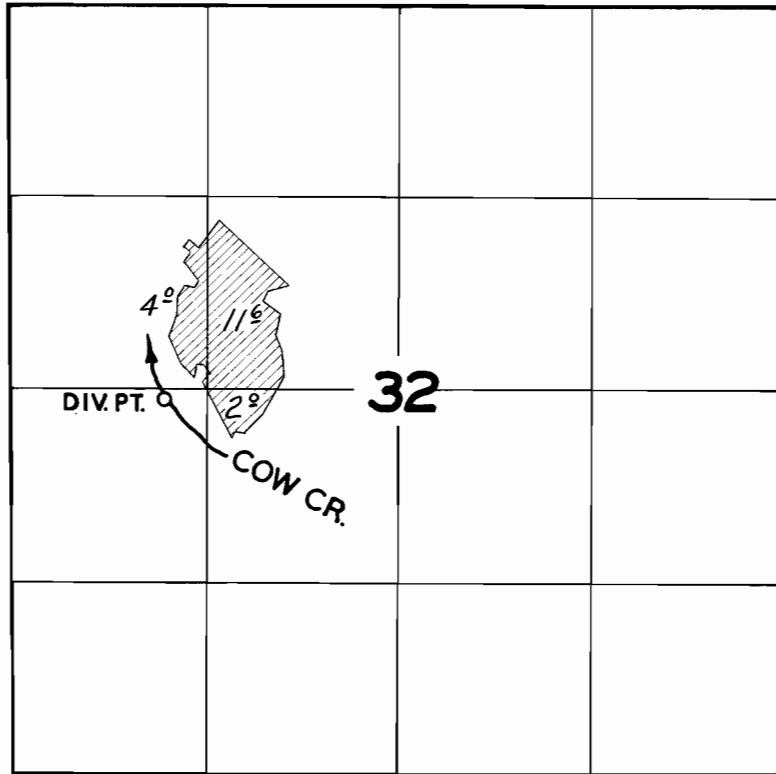

FINAL PROOF SURVEY
UNDER

Application No. 25788 Permit No. 20163
IN NAME OF

JAMES C. SMITH

Surveyed JUNE 19, 1957, by *C. O. Burtis*