


T. 7S. R. 2W. W.M.

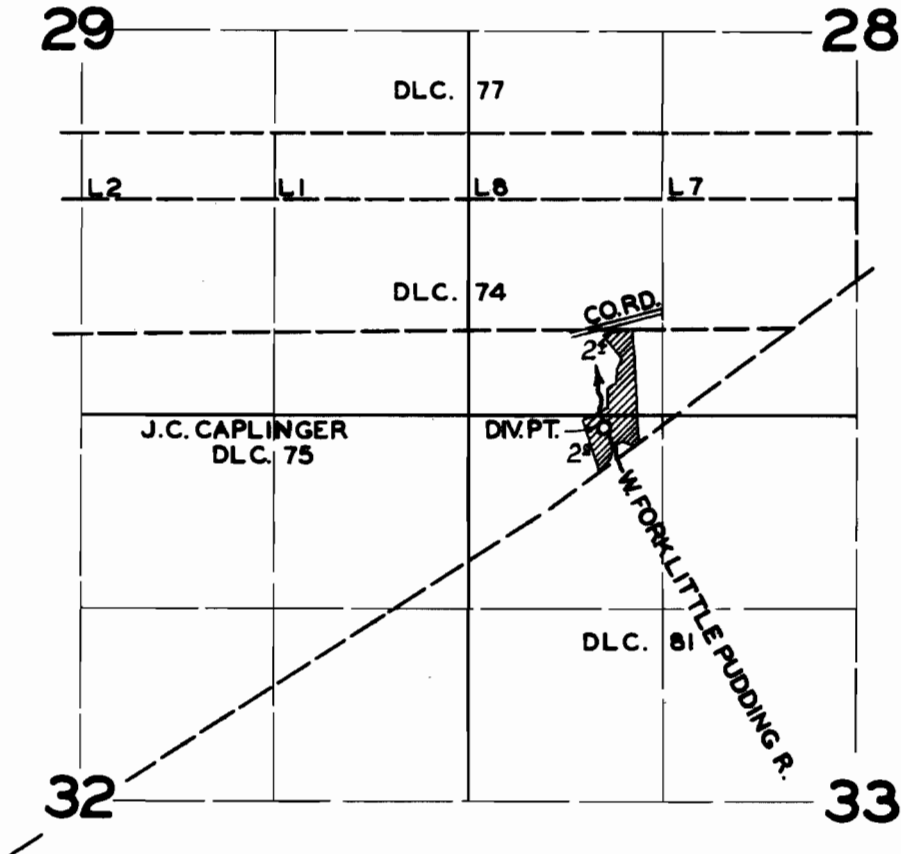

FINAL PROOF SURVEY
UNDER

Application No. 25978 Permit No. 20360
IN NAME OF

RAYMOND L. & GLADYS M. PHILLIPS

Surveyed MAR. 26 1957, by C.O. BARTELS.