


T. 21 S. R. 2 W. W. M.

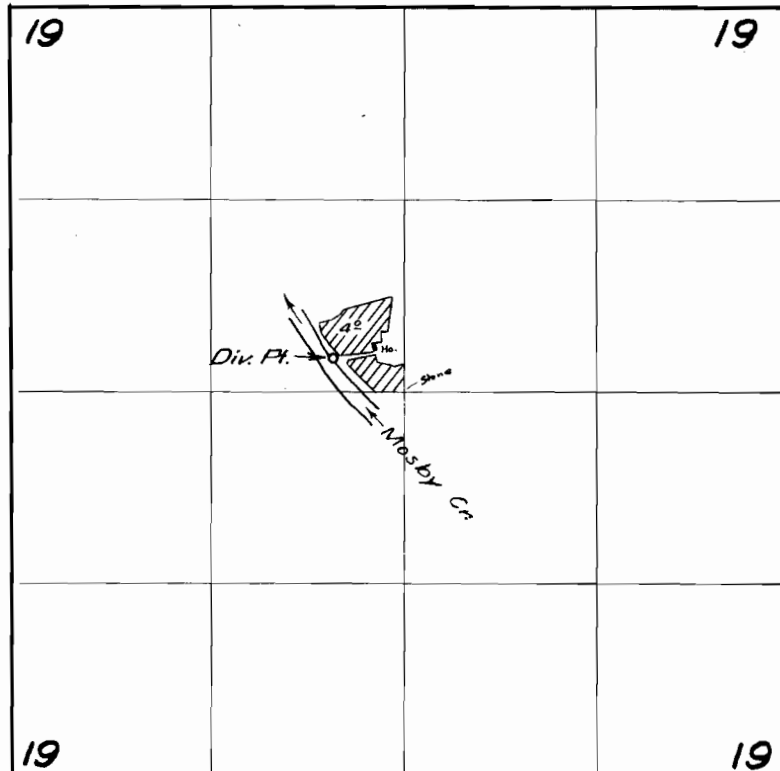

FINAL PROOF SURVEY
UNDER

Application No. 26224 Permit No. 20444

IN NAME OF

Bert C. Myers

Surveyed April 10 1957, by Tom Besh