


T. 4S. R. IW. W.M.

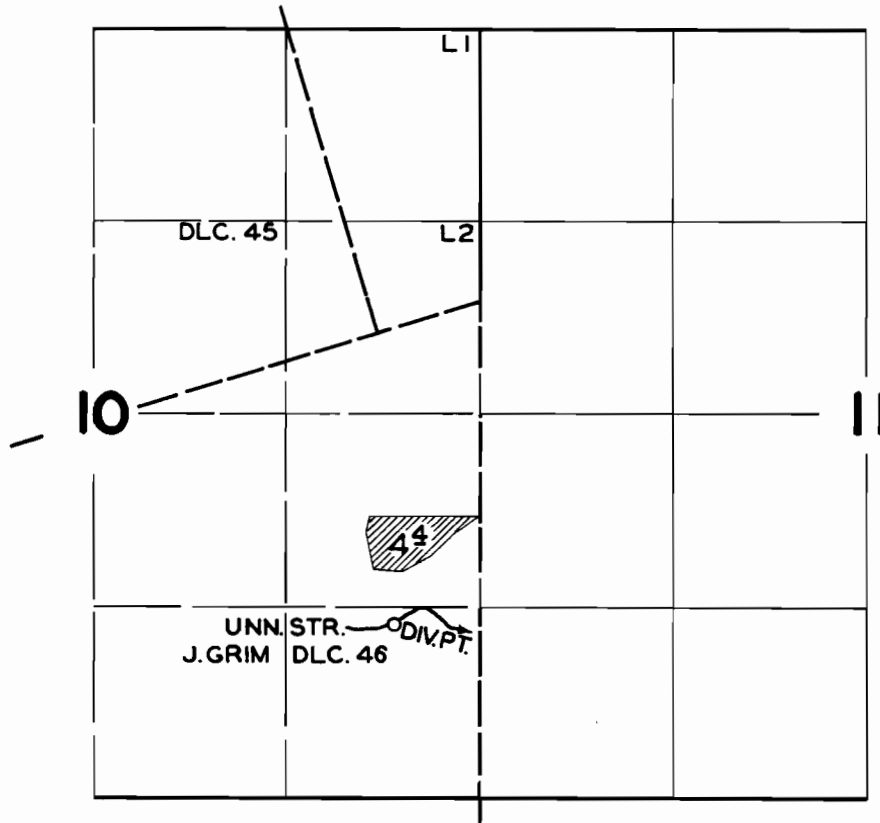

FINAL PROOF SURVEY

UNDER

Application No. 24991 . Permit No. 20490 .

IN NAME OF

GLENN OSGOOD

Surveyed MAR. 19 . 1957 , by C.O. BARTELS .