


# SURVEYORS CERTIFICATE

I, W.E. Anderson of Tillamook Ore do hereby certify that this map was made from notes taken by me in Aug 1951, and that the monument shown is with reference to the S.W. cor. of Sec. 6, T.3.N.R.9.W.W.M. W.E. Anderson  
County Surv.

**Application No 26363**  
**Permit No 20689**

HW 1/4 SW 1/4	21.50 Ac
NE 1/4 SW 1/4	31.90
NW 1/4 SE 1/4	1.00
TOT.	54.40 Ac

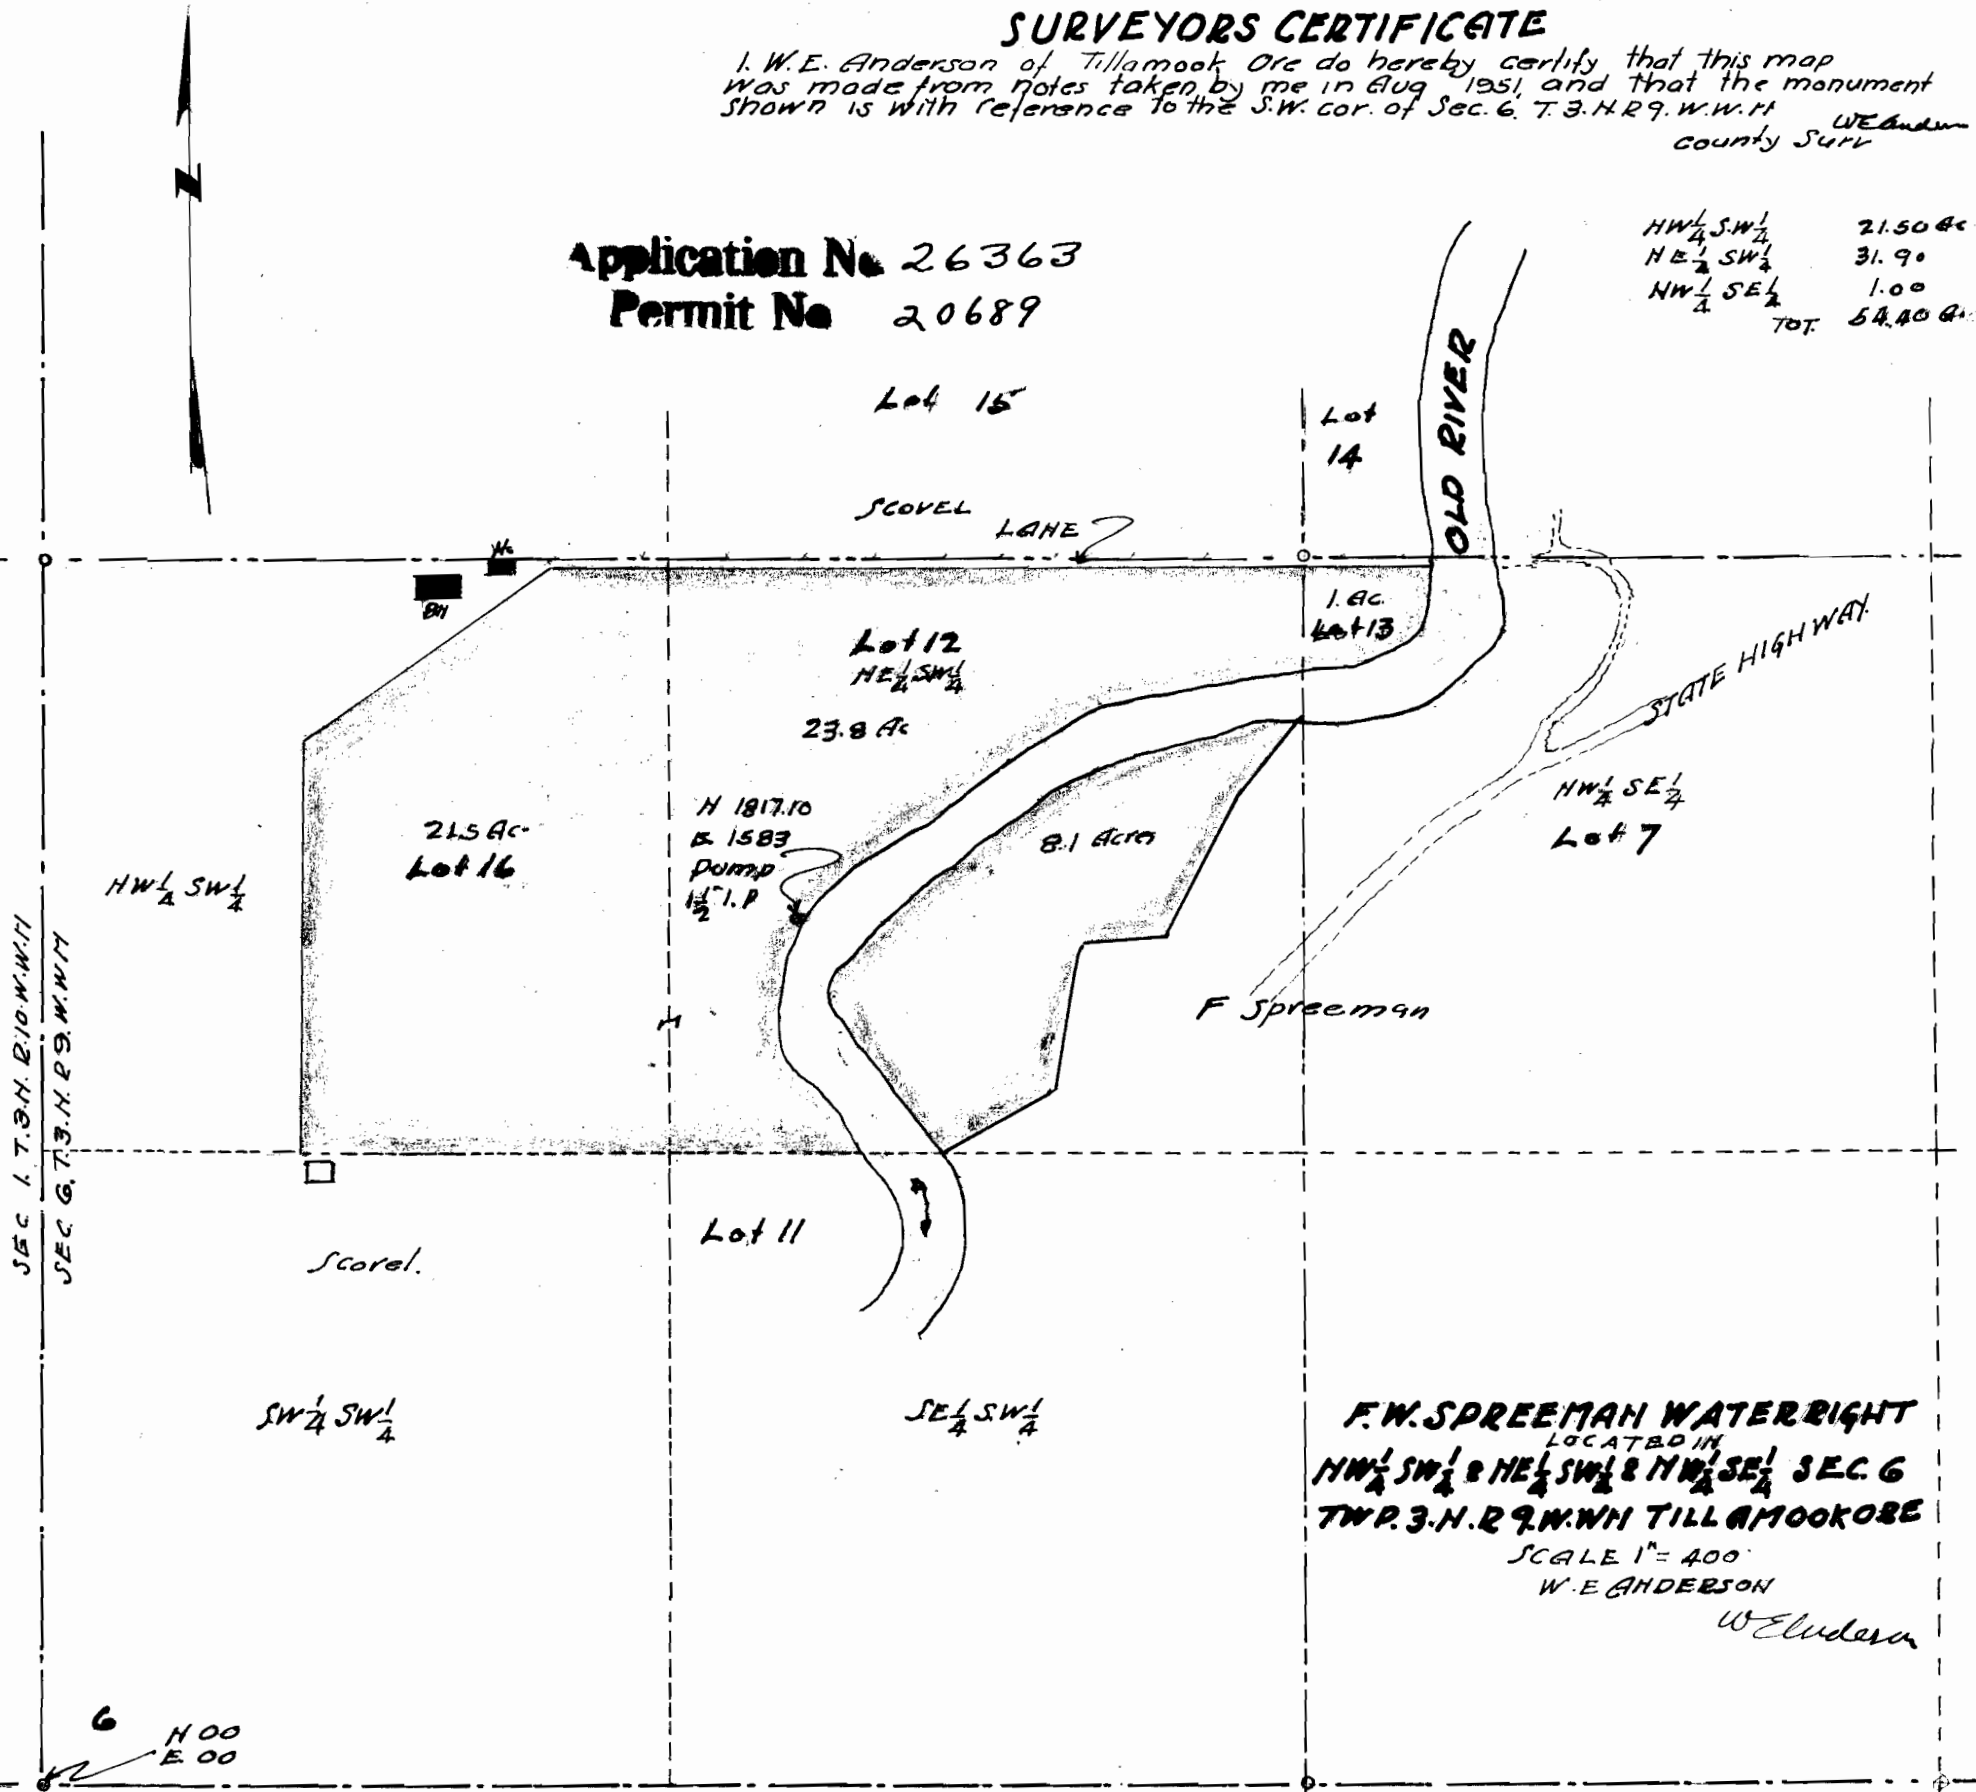

**F.W. SPREEMAN WATER RIGHT**  
LOCATED IN  
NW 1/4 SW 1/4 & NE 1/4 SW 1/4 & NW 1/4 SE 1/4 SEC. 6  
TWP. 3. N. R. 9. W. WM TILLAMOOK ORE  
SCALE 1" = 400'  
W. E. ANDERSON

*W. E. Anderson*

1  
6  
12  
7  
H 00  
E 00