


T. 13S. R. 16E. W.M.

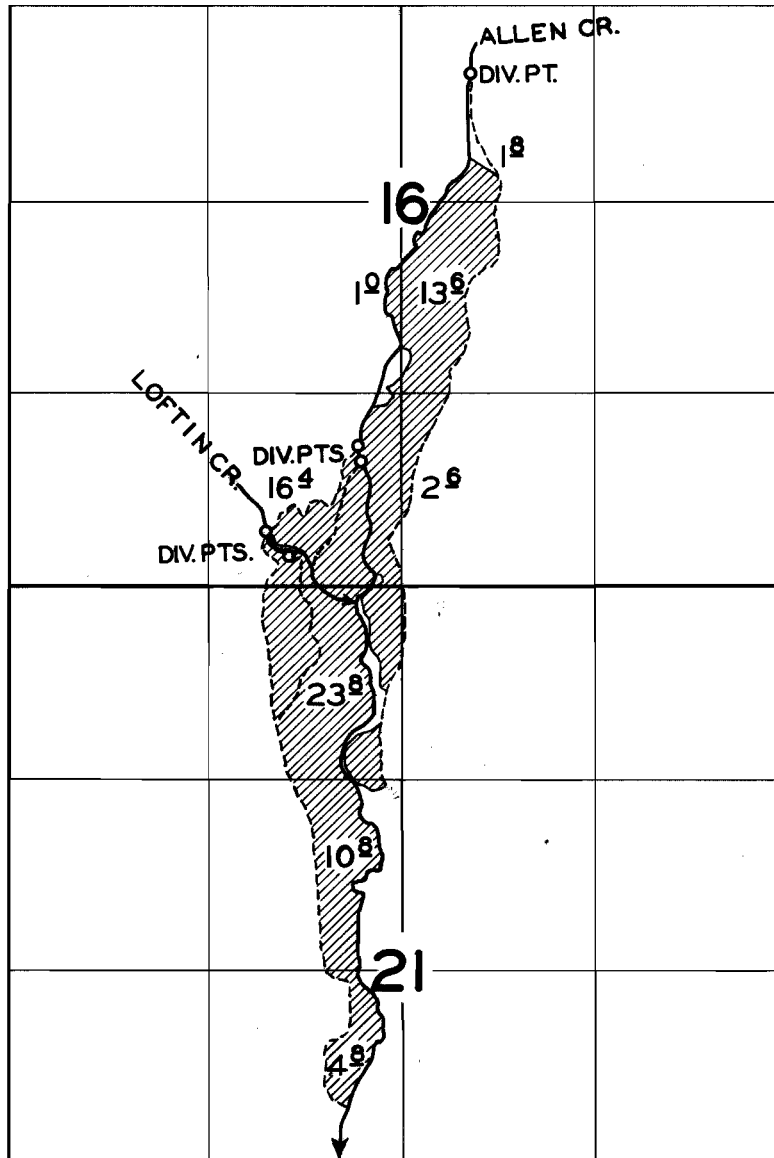

FINAL PROOF SURVEY
UNDER

Application No. 26392 Permit No. 20705
IN NAME OF

FLOYD JONES

Surveyed AUG. 2, 1957, by C.O. BARTELS