


T.14S.R.6W.W.M.

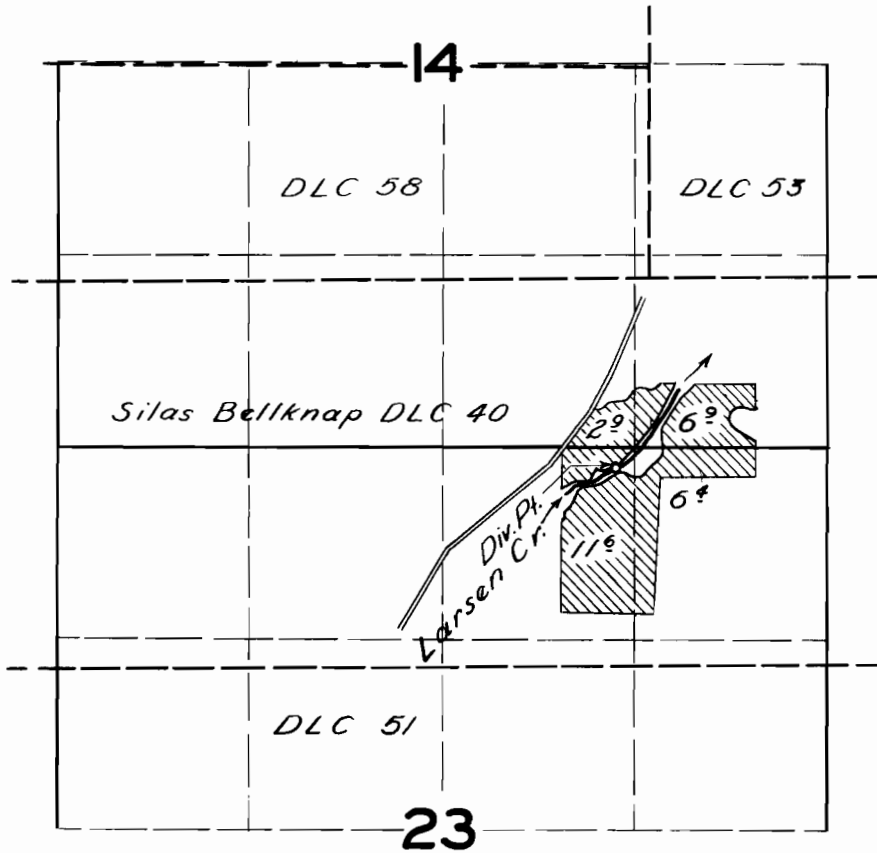

FINAL PROOF SURVEY  
UNDER

Application No. 26597 Permit No. 20834  
IN NAME OF

LINCOLN B. CHAMBERS

Surveyed 23 Apr. 1957, by *[Signature]*