


T.11 S. R. 2 W.W.M.

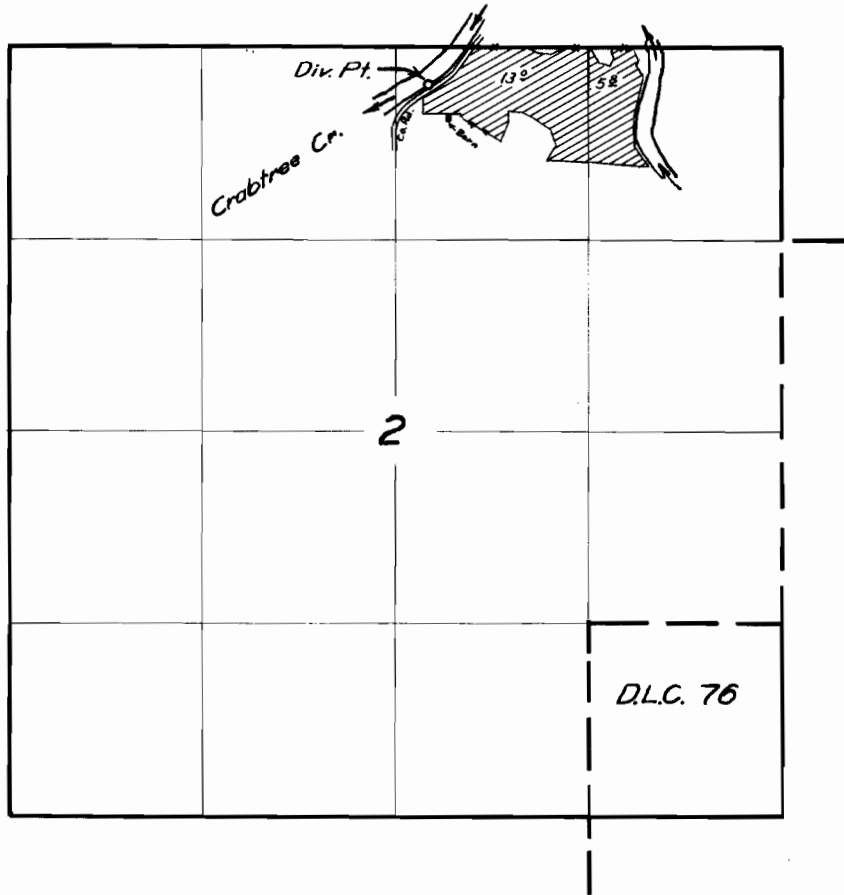

FINAL PROOF SURVEY
UNDER

Application No. 26666 Permit No. 20881

IN NAME OF

Jim W., Mary A., & Harold M. Bond

Surveyed Mar. 18 1957, by Tom B. Bish