


T.15S.R.5W.W.M.

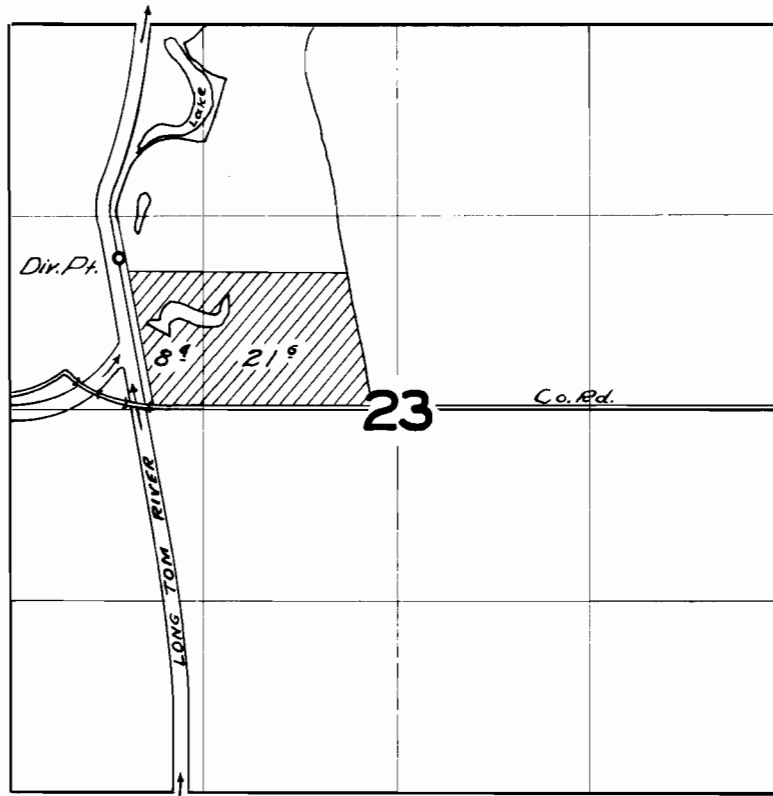

FINAL PROOF SURVEY
UNDER

Application No. 26789 Permit No. 21046
IN NAME OF

ELBERT L. STARNES

Surveyed 16 April 1957, by SC Whitby