


T.18S.R.1W.W.M.

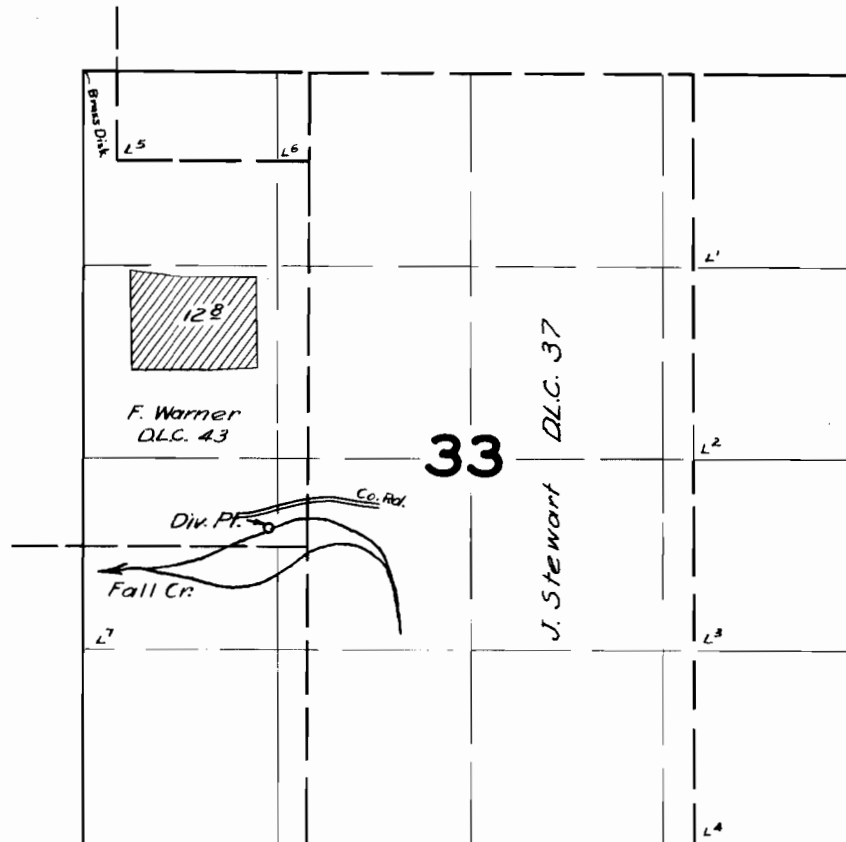

FINAL PROOF SURVEY
UNDER

Application No. 27000... Permit No. 21206...
IN NAME OF

.....*Vietta Frances Lawrence*.....

Surveyed *June 19* 1957, by *M. Bish*.....