


T.21 S.R.2W.W.M.

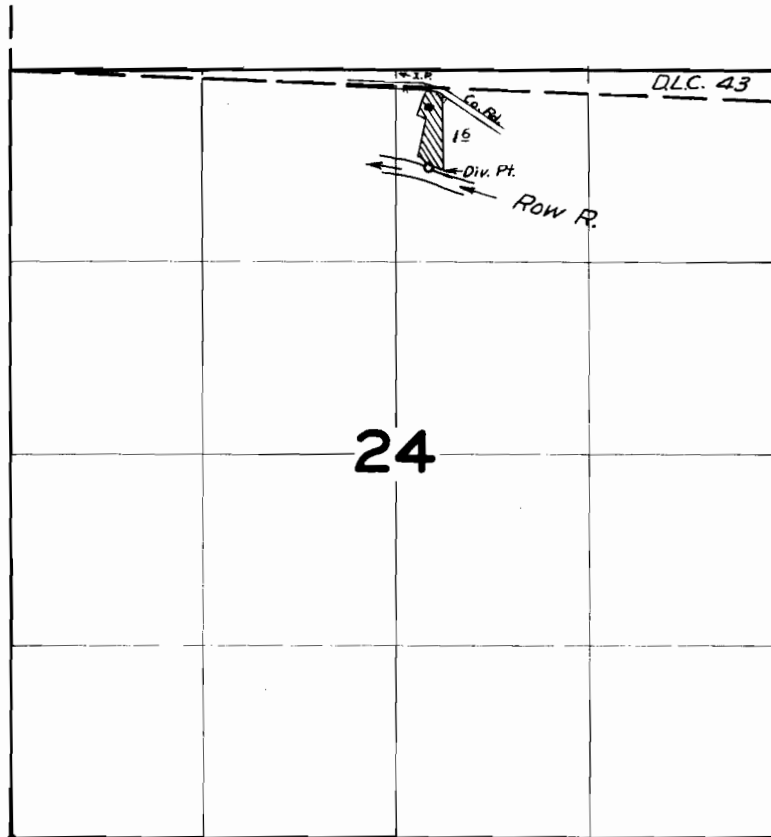

FINAL PROOF SURVEY
UNDER

Application No. 26223 Permit No. 21253
IN NAME OF

LeRoy & Ruth Cartwright

Surveyed April 15 1957, by M. B. Bish