


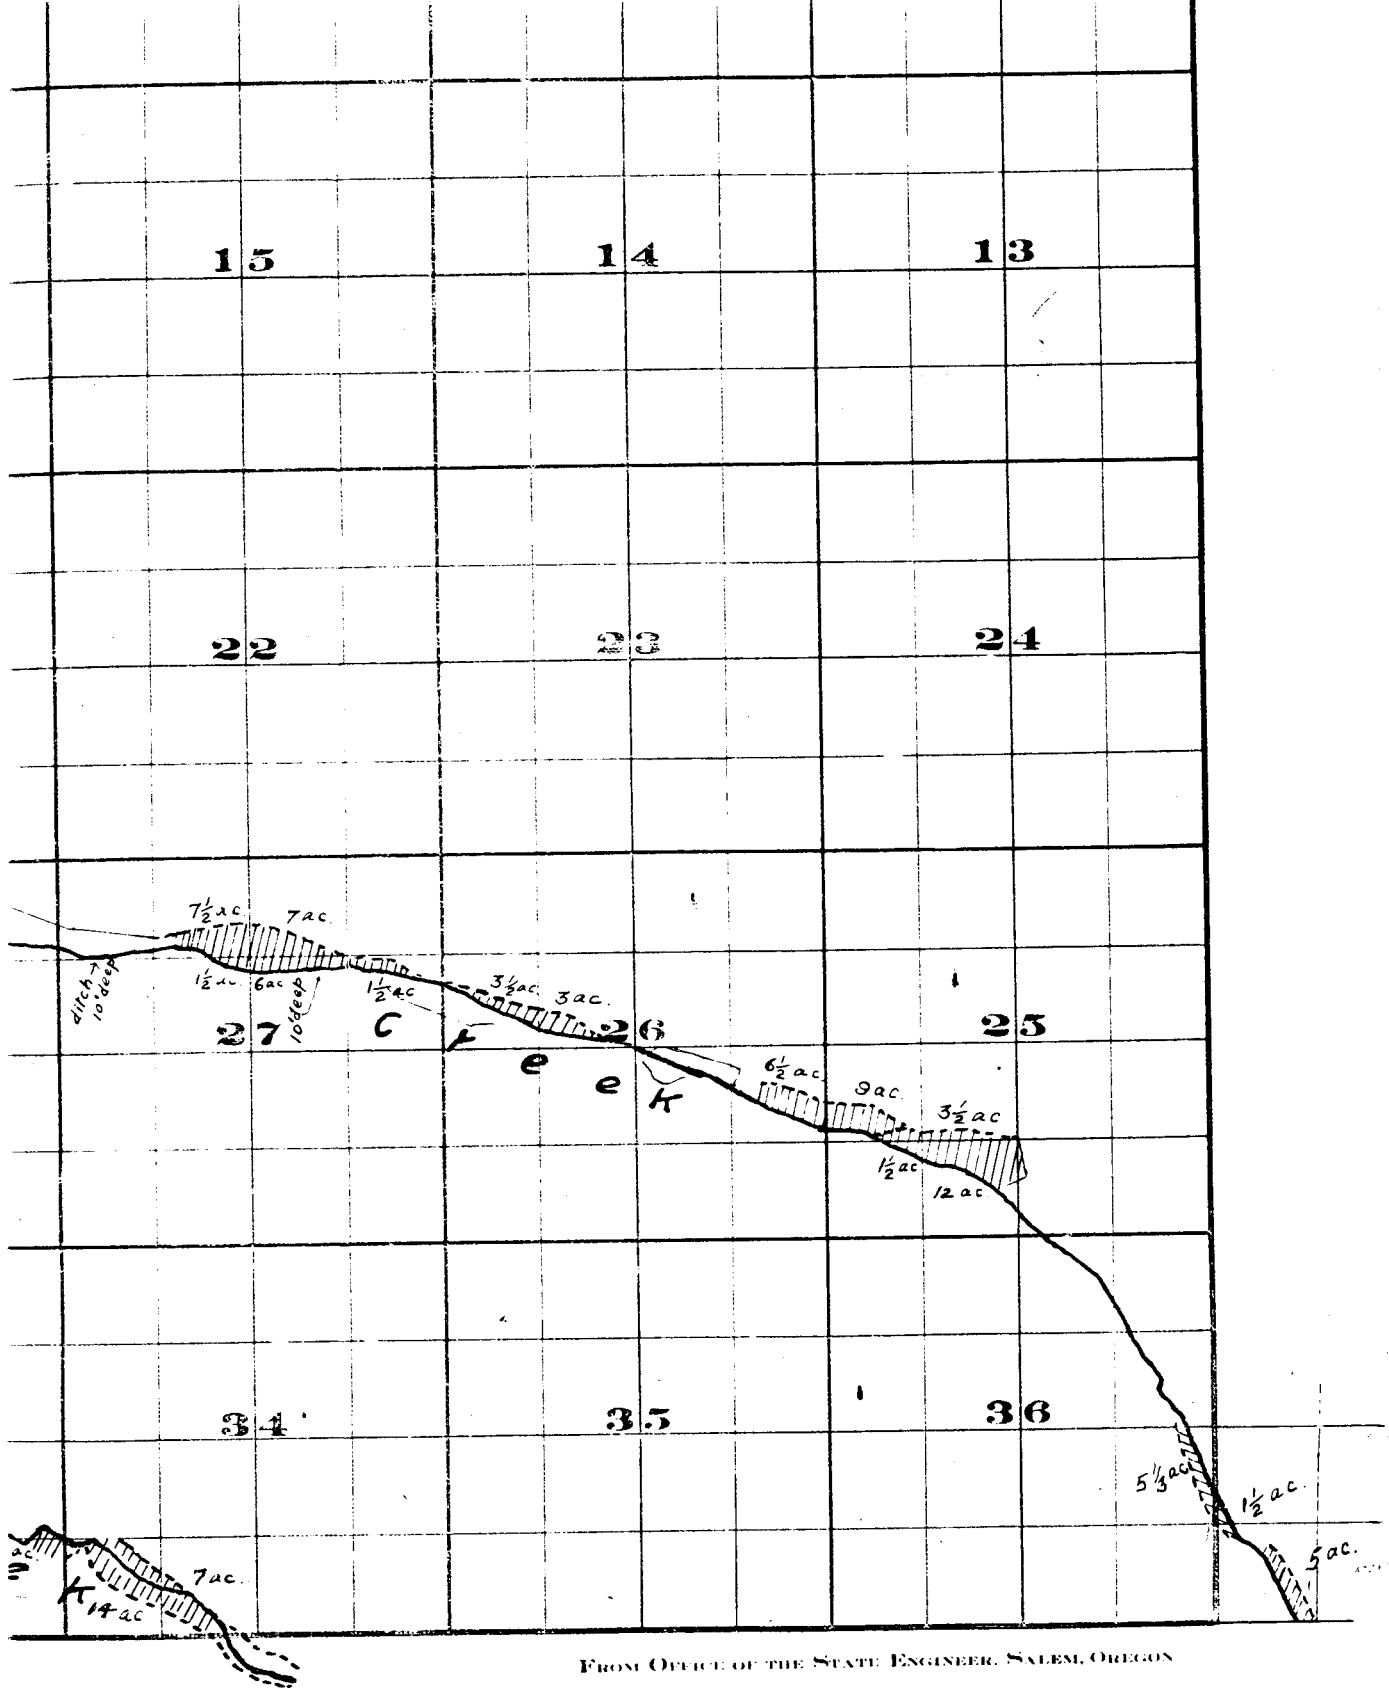

per July 1909
 State Engineer


Willow Creek Adjudication

2 S. 27 E.

Part 2 S. 28 E.

Part 3 S. 27 E.

Township 2 S.

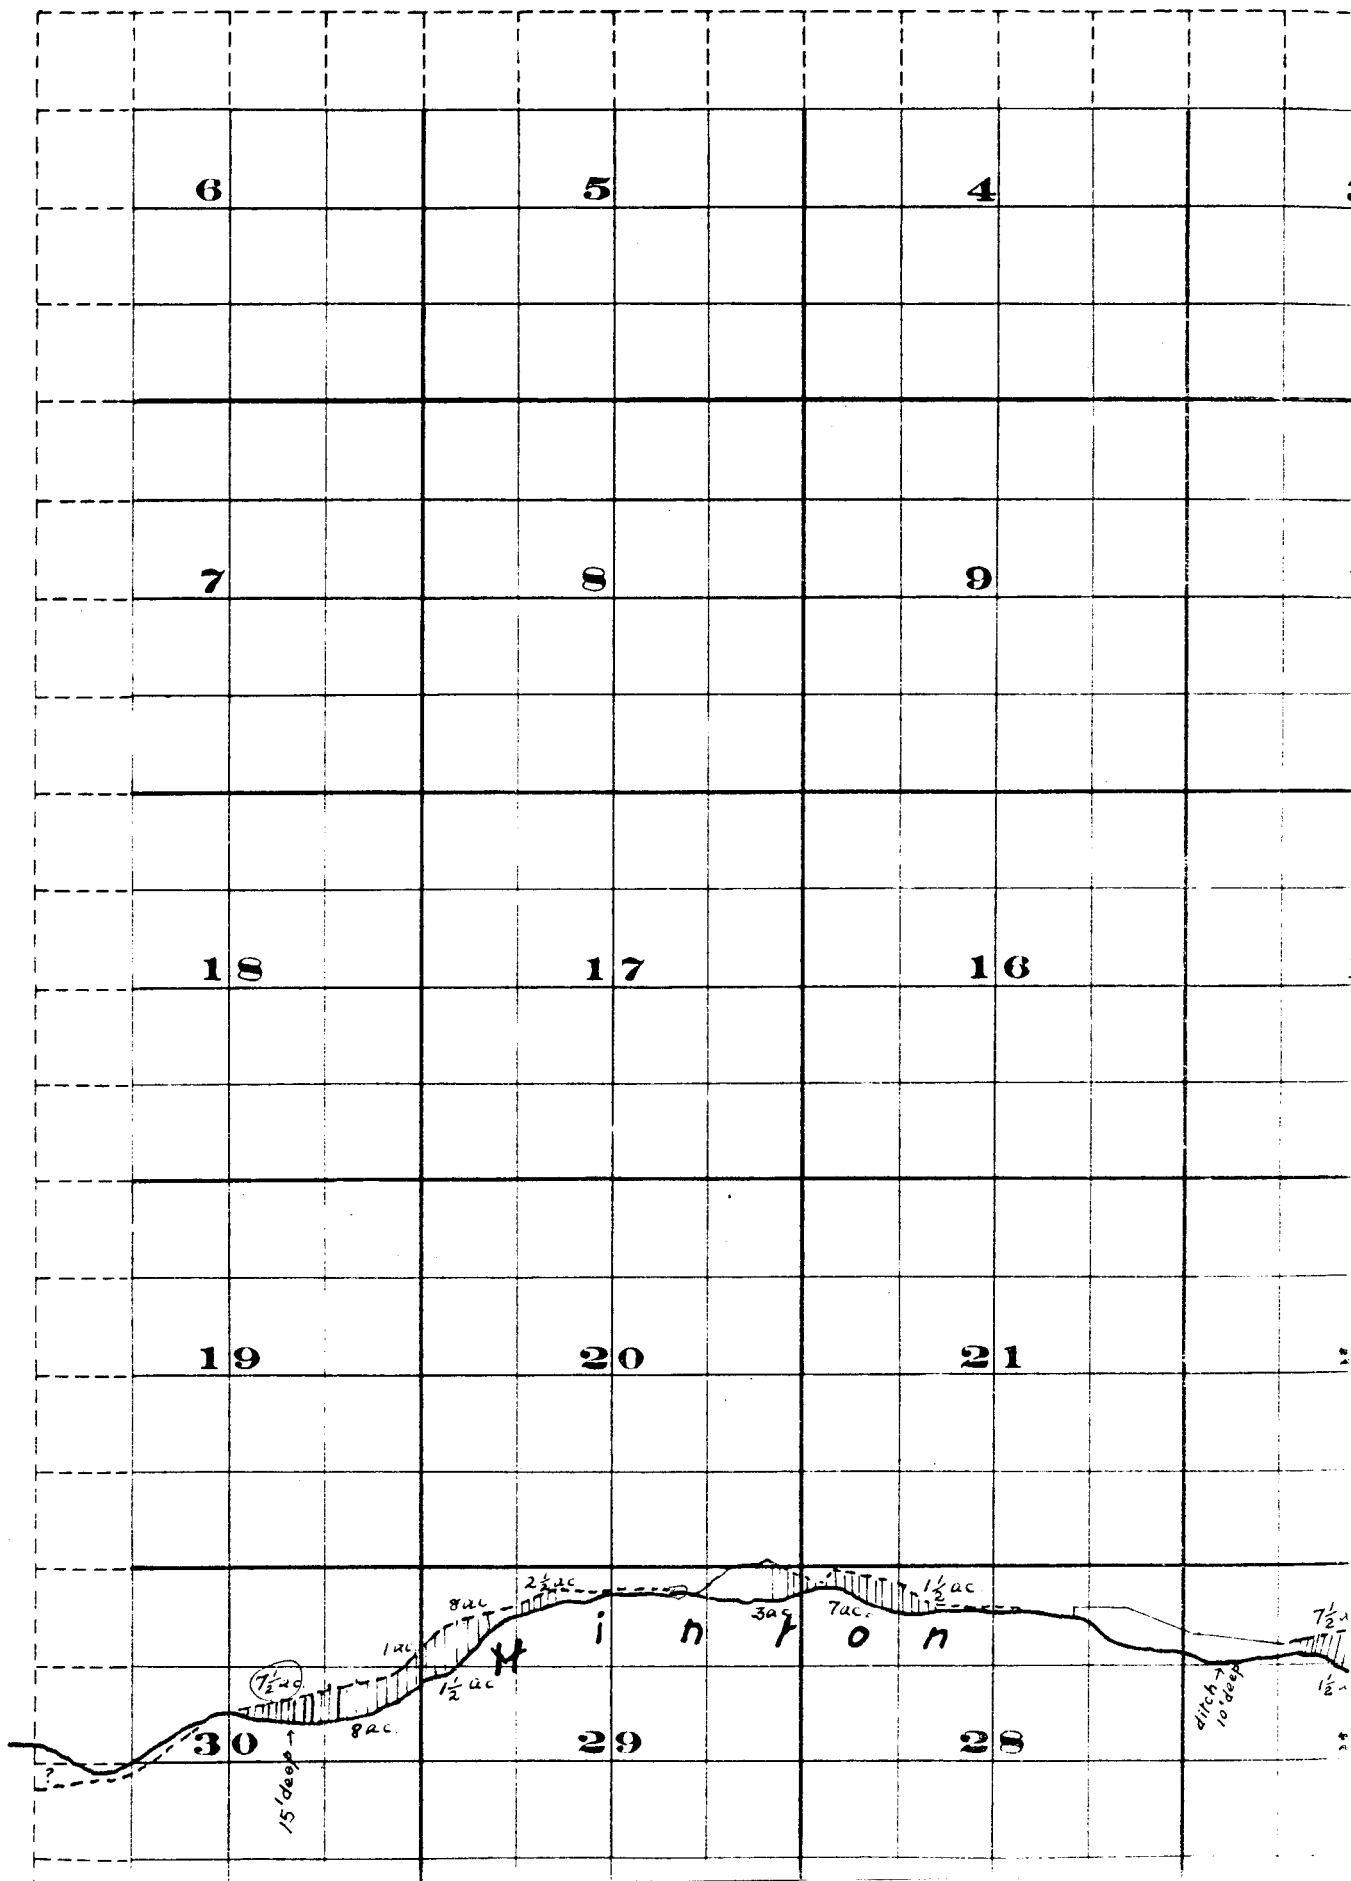

,

[illegible]