


T. I O S. R. I W. W. M.

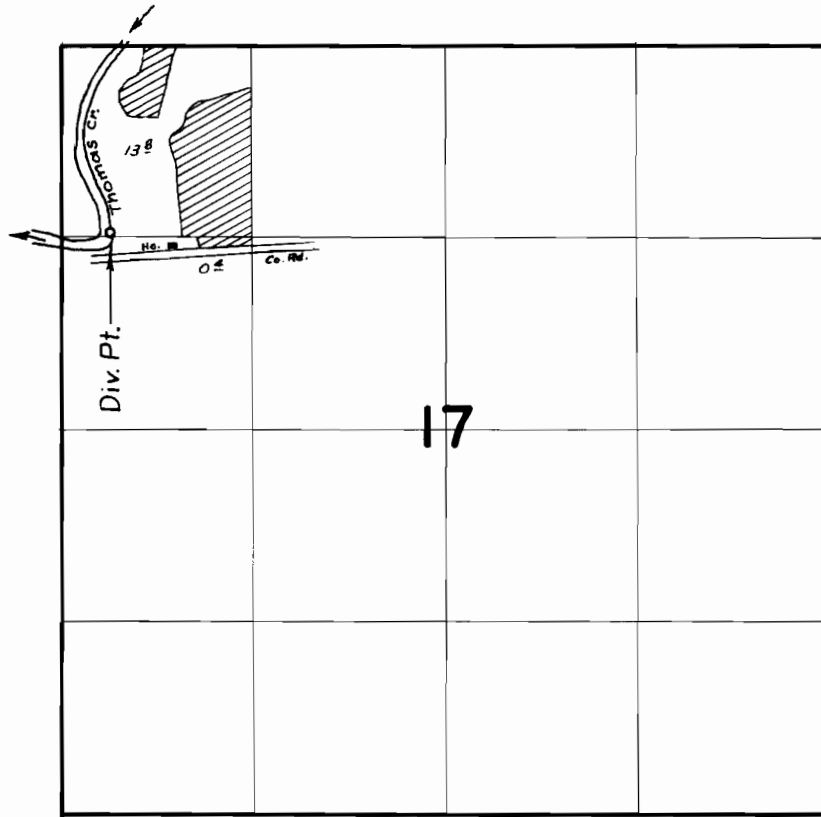

**FINAL PROOF SURVEY**

UNDER

Application No. 27140..... Permit No. 21348.....

IN NAME OF

Glen A. or Dellarea L. Holland

Surveyed Mar. 19 1957, by M. Bish.....