


T.21 S. R. 3 W. W. M.

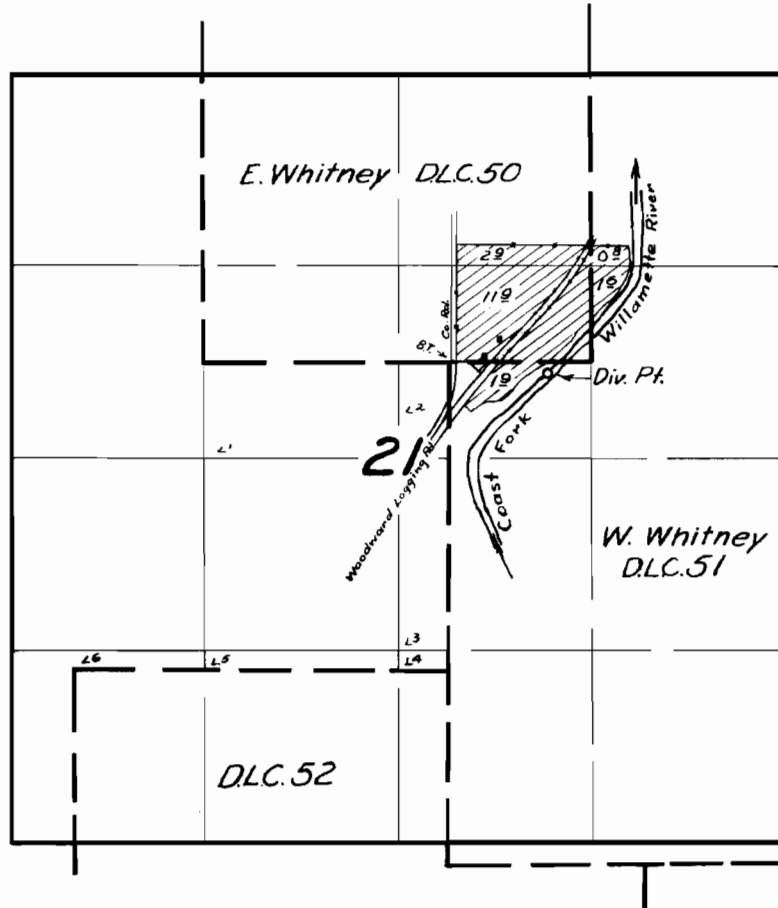

FINAL PROOF SURVEY  
UNDER

Application No. 27359 Permit No. 21540  
IN NAME OF

J. A. Heath

Surveyed April 9 1957, by T. M. Bish