


T.21 S.R.3W.W.M.

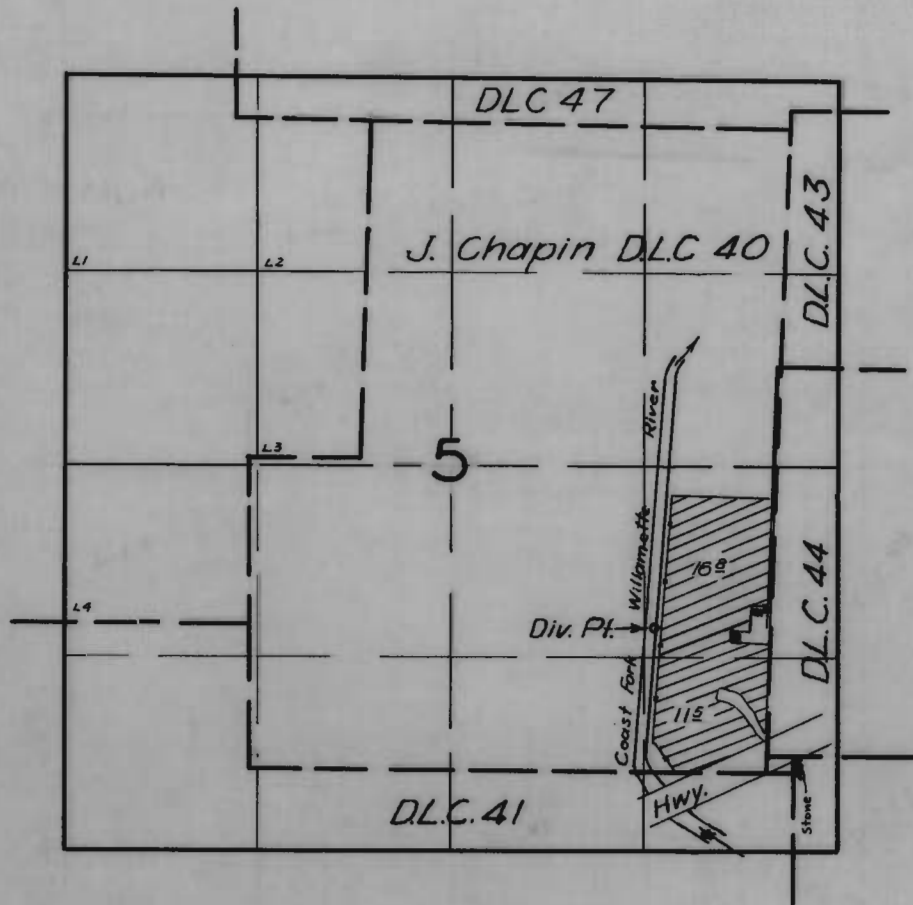

**FINAL PROOF SURVEY**  
UNDER

Application No. 27452... Permit No. 21612...  
IN NAME OF

..... *Ira J. Beidler* .....

Surveyed *April 8, 1957*, by *M. Bish* .....