


T.19 S.R.3 W.W.M.

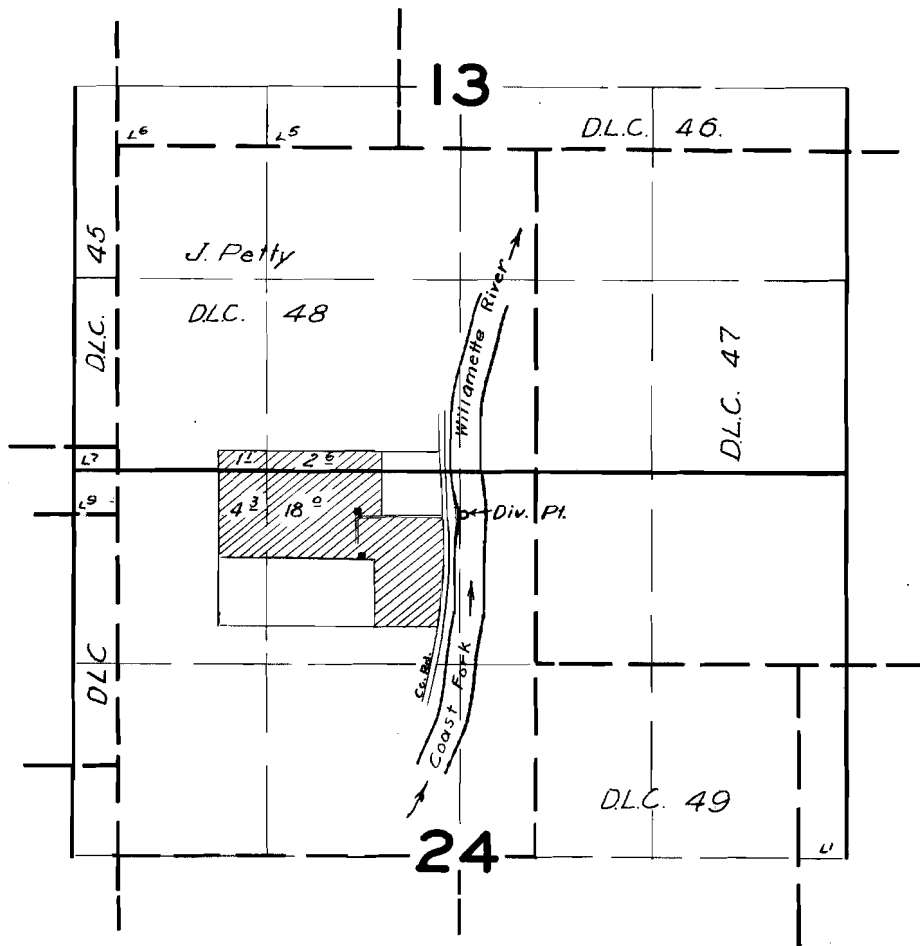

FINAL PROOF SURVEY UNDER

Application No. 27544 ... Permit No. 21697 ...
IN NAME OF

.....*W.W. & Crystal Hileman*.....

Surveyed *April 24, 1957*, by *Tom Bish*.....